

MISSISSIPPI DEPARTMENT OF NATURAL RESOURCES
Bureau of Land and Water Resources

P.O. Box 10631
Jackson, Mississippi 39209
WATER WELL DRILLERS LOG

COUNTY WELL LOCATED <i>Harrison</i>	
WELL NUMBER <i>H 2447</i>	CODED
DATE WELL COMPLETED <i>5-14-87</i>	

PERMIT NUMBER
NAME OF DRILLING FIRM <i>M & B Drilling Co.</i>

NAME & MAILING ADDRESS OF LANDOWNER <i>Mr. Gene Stroko</i>			
<i>Rt. 1 Box 772H</i>			
<i>Biloxi, Miss. 39532</i>			
WELL LOCATION	SEC	TOWNSHIP	RANGE
	<i>23</i>	<i>6 S</i>	<i>10 W</i>
DISTANCE	DIRECTION	NEAREST TOWN	
<i>2 1/2</i> Miles	<i>NE</i>	of <i>Woolmarket</i>	
OTHER LANDMARK			
WELL PURPOSE: Home, Irrigation, Municipal, Industrial, Fish Pond, etc. <i>Home</i>			

PUMP DATA		
PUMP TYPE (Circle One): <u>Submersible</u> , Turbine, Jet, Flowing Well, Other (Describe) _____		
POWER TYPE (Circle One): <u>Electric</u> , Tractor, Diesel, Gasoline, Butane, Other (Describe) _____		
Pump Capacity (GPM) <i>22</i>	No. of Stages	Setting Depth <i>100</i> FT.
PUMP TEST		
Well yielded <i>22</i> GPM with a drawdown of _____ ft. after _____ hours of pumping		

WELL DATA		
Well Depth <i>560</i>	Casing Diameter (In.) <i>4" x 2"</i>	Casing Length (Ft.) <i>540</i>
Type of Casing <i>PVC</i>	Hole Depth <i>560</i>	Depth to Static Water Level <i>120</i>
TYPE OF COMPLETION: (Circle One or More): <u>Gravel Packed</u> , Underreamed, Telescoped, <u>Natural Development</u> , Open Hole, Other		
Top of Lap Pipe or Reduction in Casing FEET		
IF TELESCOPED OR MORE THAN ONE SCREEN: USE BACK PAGE		

LOG DATA	
TYPE OF LOG RUN (Circle One): Electric, Gamma Ray, Density, Sonic, <u>No Log Run</u> , Neutron, Other (Describe) _____	
Name of Organization Running Log	

SCREEN DATA		
Diameter - Inches <i>2"</i>	Length - Feet <i>10</i>	Slot Size - Inches <i>.00P</i>
Screen Type <i>PVC WOP</i>	Depth to Bottom - Feet <i>550 - 10 FT Turf PVC</i>	

GEOLOGIC DATA (Office Use Only)			
Surface Elev.	Geologic Unit	Unit Thickness	Depth to Top
Subs. SWL	Date	Analysis	Aquifer Test

Driller's Remarks

DESCRIPTION OF FORMATIONS ENCOUNTERED	FROM	TO	FORMATION (S) (continued)	FORMATION TO
<i>Surface</i>	<i>0</i>	<i>4</i>		
<i>Red Clay</i>	<i>4</i>	<i>20</i>		
<i>Red Clay & Sand layers</i>	<i>20</i>	<i>100</i>		
<i>Blue Clay</i>	<i>100</i>	<i>300</i>		
<i>Clay & Sand Brecks</i>	<i>300</i>	<i>370</i>		
<i>Blue Clay</i>	<i>370</i>	<i>470</i>		
<i>Blue Clay / Sand</i>	<i>470</i>	<i>557</i>		
<i>Blue Clay</i>	<i>557</i>	<i>560</i>		


RECEIVED

AUG 24 1987

Department of Natural Resources
Bureau of Land & Water Resources

IF MORE SPACE IS NEEDED, USE BACK

If well telescopes please sketch and show depths.

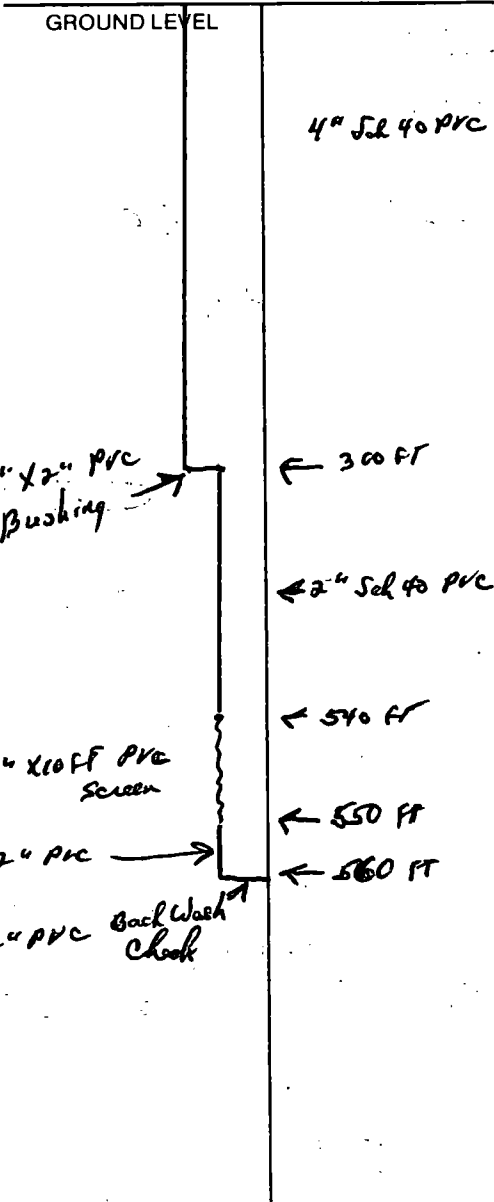

X			

SECTION 23

Please indicate well location X.

ADDITIONAL INFORMATION

If more than one screen, show location of each on sketch.