

# MISSISSIPPI DEPARTMENT OF NATURAL RESOURCES

Bureau of Land and Water Resources

P.O. Box 10631  
Jackson, Mississippi 39209  
WATER WELL DRILLERS LOG

COUNTY WELL LOCATED <b>Harrison</b>	
WELL NUMBER <b>H 2448</b>	CODED
DATE WELL COMPLETED <b>4-17-87</b>	

PERMIT NUMBER
NAME OF DRILLING FIRM <b>Coast Water Well Svc. Inc.</b>

NAME & MAILING ADDRESS OF LANDOWNER <b>Glenn Freeman 242 Larkin Place East Biloxi, MS</b>			
WELL LOCATION:	SEC <b>35</b>	TOWNSHIP <b>6<sup>N</sup><sub>S</sub></b>	RANGE <b>10<sup>W</sup></b>
DISTANCE <b>4</b> Miles	DIRECTION <b>N</b>	NEAREST TOWN of <b>Biloxi</b>	
OTHER LANDMARK			
WELL PURPOSE: Home, Irrigation, Municipal, Industrial, Fish Pond, etc. <b>home</b>			

<b>PUMP DATA</b>		
PUMP TYPE (Circle One): Submersible, Turbine, <input checked="" type="radio"/> <b>Jet</b> Flowing Well, Other (Describe) _____		
POWER TYPE (Circle One): <input checked="" type="radio"/> <b>Electric</b> Tractor, Diesel, Gasoline, Butane, Other (Describe) _____		
Pump Capacity (GPM) <b>8</b>	No. of Stages <b>2</b>	Setting Depth <b>+</b> FT.
PUMP TEST Well yielded _____ GPM with a drawdown of _____ ft. after _____ hours of pumping		

<b>WELL DATA</b>		
Well Depth <b>495'</b>	Casing Diameter (In.) <b>2"</b>	Casing Length (Ft.) <b>470'</b>
Type of Casing <b>Pvc</b>	Hole Depth <b>495'</b>	Depth to Static Water Level <b>40ft.</b>
TYPE OF COMPLETION: (Circle One or More) <input checked="" type="checkbox"/> <b>Natural Development</b> , <input type="checkbox"/> Gravel Packed, <input type="checkbox"/> Underreamed, <input type="checkbox"/> Telescoped, <input type="checkbox"/> Open Hole, <input type="checkbox"/> Other (Describe) _____		
Top of Lap Pipe or Reduction in Casing <b>FEET</b> IF TELESCOPED OR MORE THAN ONE SCREEN: USE BACK PAGE		

<b>LOG DATA</b>	
TYPE OF LOG RUN (Circle One): Electric, Gamma Ray, Density, Sonic, <input checked="" type="radio"/> <b>No Log Run</b> , Neutron, Other (Describe) _____	
Name of Organization Running Log	

<b>SCREEN DATA</b>		
Diameter - Inches <b>2"</b>	Length - Feet <b>20'</b>	Slot Size - Inches <b>.007</b>
Screen Type <b>Pvc</b>	Depth to Bottom - Feet <b>490'</b>	


<b>GEOLOGIC DATA (Office Use Only)</b>			
Surface Elev.	Geologic Unit	Unit Thickness	Depth to Top
Subs. SWL	Date	Analysis	Aquifer Test
Driller's Remarks			

DESCRIPTION OF FORMATIONS ENCOUNTERED	FROM	TO	FORMATIONS (Continued)	FROM	TO
<b>Top Soil</b>	<b>0</b>	<b>2</b>	<b>RECEIVED</b>  <b>SEP 21 1987</b>  <b>Department of Natural Resources Bureau of Land &amp; Water Resources</b>		
<b>Blue Clay</b>	<b>2</b>	<b>400</b>			
<b>Med Gray Sand</b>	<b>400</b>	<b>485</b>			
<b>Coarse Gray Sand w/ Pea Gravel</b>	<b>485</b>	<b>490</b>			
<b>Blue Clay</b>	<b>490</b>	<b>495</b>			

IF MORE SPACE IS NEEDED, USE BACK

If well telescopes please sketch and show depths.

GROUND LEVEL

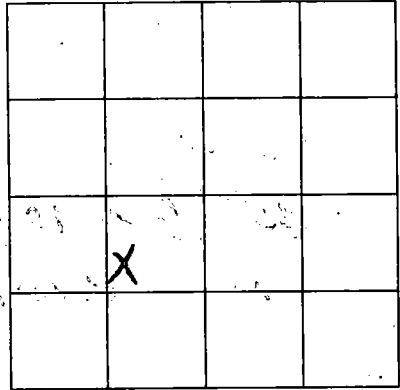

SECTION 35

Please indicate well location X.

ADDITIONAL INFORMATION

Lined area for additional information.

REVERSE SIDE

as well as location of telescopes  
see well record to show to record

If more than one screen,  
show location of each on sketch.