

**MISSISSIPPI DEPARTMENT OF NATURAL RESOURCES**  
Bureau of Land and Water Resources

P.O. Box 10631  
Jackson, Mississippi 39209  
**WATER WELL DRILLERS LOG**

COUNTY WELL LOCATED <b>Harrison</b>	
WELL NUMBER <b>H</b>	CODED
<b>2449</b>	
DATE WELL COMPLETED <b>6-4-87</b>	

PERMIT NUMBER
NAME OF DRILLING FIRM <b>Coast Water Well Svc</b>

NAME & MAILING ADDRESS OF LANDOWNER <b>Virginia Sawton</b> <b>145 Lamey Lane</b> <b>Bellevue MS 39532</b>		
WELL LOCATION: SEC	TOWNSHIP	RANGE
<b>18</b>	<b>6<sup>N</sup></b>	<b>9<sup>W</sup></b>
DISTANCE <b>6</b> Miles	DIRECTION <b>NW</b>	NEAREST TOWN <b>Bellevue MS</b>
OTHER LANDMARK		
WELL PURPOSE: Home, Irrigation, Municipal, Industrial, Fish Pond, etc. <b>home</b>		

<b>PUMP DATA</b>		
PUMP TYPE (Circle One): Submersible, Turbine, <b>Jet</b> Flowing Well, Other (Describe) _____		
POWER TYPE (Circle One): <b>Electric</b> Tractor, Diesel, Gasoline, Butane, Other (Describe) _____		
Pump Capacity (GPM) <b>12</b>	No. of Stages <b>2</b>	Setting Depth <b>FT.</b>
PUMP TEST		
Well yielded _____ GPM with a drawdown of _____ ft. after _____ hours of pumping		

<b>WELL DATA</b>		
Well Depth <b>236'</b>	Casing Diameter (In.) <b>2"</b>	Casing Length (Ft.) <b>221'</b>
Type of Casing <b>PRC</b>	Hole Depth <b>236'</b>	Depth to Static Water Level <b>30'</b>
TYPE OF COMPLETION: (Circle One or More): Gravel Packed, Underreamed, Telescoped, <b>Natural Development</b> Open Hole, Other (Describe) _____		
Top of Lap Pipe or Reduction in Casing <b>FEET</b> IF TELESCOPED OR MORE THAN ONE SCREEN: USE BACK PAGE		

<b>LOG DATA</b>	
TYPE OF LOG RUN (Circle One): Electric, Gamma Ray, Density, Sonic, Neutron, Other (Describe) <b>No Log Run</b>	
Name of Organization Running Log	

<b>SCREEN DATA</b>		
Diameter - Inches <b>2"</b>	Length - Feet <b>10'</b>	Slot Size - Inches <b>.008</b>
Screen Type <b>PRC</b>	Depth to Bottom - Feet <b>231'</b>	

<b>GEOLOGIC DATA (Office Use Only)</b>			
Surface Elev.	Geologic Unit	Unit Thickness	Depth to Top
Subs. SWL	Date	Analysis	Aquifer Test

Driller's Remarks


**RECEIVED**

DESCRIPTION OF FORMATIONS ENCOUNTERED	FROM	TO
<b>Brown Clay</b>	<b>0</b>	<b>10</b>
<b>White Coarse Sand</b>	<b>10</b>	<b>40</b>
<b>Blue Clay</b>	<b>40</b>	<b>42</b>
<b>White Coarse Sand</b>	<b>42</b>	<b>83</b>
<b>Blue Clay</b>	<b>83</b>	<b>200</b>
<b>Med Gray Sand</b>	<b>200</b>	<b>233</b>
<b>Blue Clay</b>	<b>233</b>	<b>236</b>

FOR ANALYSIS (Continued)		
	FROM	TO
<b>SEP 21 1987</b>		
<b>Department of Natural Resources</b> <b>Bureau of Land &amp; Water Resources</b>		
IF MORE SPACE IS NEEDED, USE BACK		

If well telescopes please sketch and show depths.

GROUND LEVEL

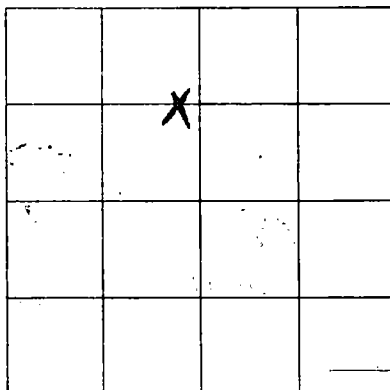

SECTION 18

Please indicate well location X.

ADDITIONAL INFORMATION

Lined area for additional information.

*[Faint, illegible text]*

If more than one screen, show location of each on sketch.