




If well telescopes please sketch and show depths.

GROUND LEVEL

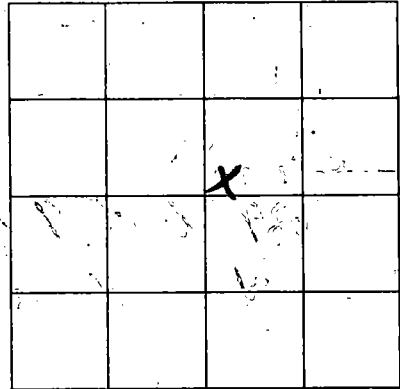

SECTION 29

Please indicate well location X.

ADDITIONAL INFORMATION

REVISIONS

DATE: 11/11/82

If more than one screen, show location of each on sketch.