

MISSISSIPPI DEPARTMENT OF NATURAL RESOURCES
Bureau of Land and Water Resources

P.O. Box 10631
Jackson, Mississippi 39209
WATER WELL DRILLERS LOG

COUNTY WELL LOCATED Harvard	WELL NUMBER (CODED) Harvard	PERMIT NUMBER
DATE WELL COMPLETED 3-19-87		NAME OF DRILLING FIRM Coast Water Well Svc. Inc.

NAME & MAILING ADDRESS OF LANDOWNER Cliffey Roberts		
16555 Hwy 15		
Biloxi MS 39532		
WELL LOCATION: SEC	TOWNSHIP	RANGE
18	6^S	9^W
DISTANCE 7 Miles	DIRECTION N	NEAREST TOWN of Biloxi
OTHER LANDMARK		
WELL PURPOSE: Home, Irrigation, Municipal, Industrial, Fish Pond, etc. Home		

PUMP DATA		
PUMP TYPE (Circle One): Submersible, Turbine, <u>Jet</u> Flowing Well, Other (Describe) _____		
POWER TYPE (Circle One): <u>Electric</u> , Tractor, Diesel, Gasoline, Butane, Other (Describe) _____		
Pump Capacity (GPM) 7	No. of Stages 2	Setting Depth — FT.
PUMP TEST		
Well yielded — GPM with a drawdown of — ft. after — hours of pumping		

WELL DATA		
Well Depth 262'	Casing Diameter (In.) 2"	Casing Length (Ft.) 247'
Type of Casing PVC	Hole Depth 262'	Depth to Static Water Level 50ft
TYPE OF COMPLETION: (Circle One or More): Gravel Packed, Underreamed, Telescoped, Natural Development, Open Hole, Other (Describe) _____		
Top of Lap Pipe or Reduction in Casing FEET IF TELESCOPED OR MORE THAN ONE SCREEN: USE BACK PAGE		

LOG DATA	
TYPE OF LOG RUN (Circle One): Electric, Gamma Ray, Density, Sonic, <u>No Log Run</u> , Neutron, Other (Describe) _____	
Name of Organization Running Log	

SCREEN DATA		
Diameter - Inches 2"	Length - Feet 10ft	Slot Size - Inches .008
Screen Type PVC	Depth to Bottom - Feet 257ft.	

GEOLOGIC DATA (Office Use Only)			
Surface Elev.	Geologic Unit	Unit Thickness	Depth to Top
Subs. SWL	Date	Analysis	Aquifer Test


Driller's Remarks

DESCRIPTION OF FORMATIONS ENCOUNTERED	FROM	TO
Top Soil	0	2
Brown Clay	2	35
White Coarse Sand	35	45
Blue Clay	45	110
Gray Med Sand	110	120
Blue Clay	120	230
Med Gray Sand	230	257
Blue Clay	257	262

FORMATIONS (Continued)	FROM	TO
RECEIVED		
SEP 21 1987		
Department of Natural Resources Bureau of Land & Water Resources		
IF MORE SPACE IS NEEDED, USE BACK		

If well telescopes please sketch and show depths.

GROUND LEVEL

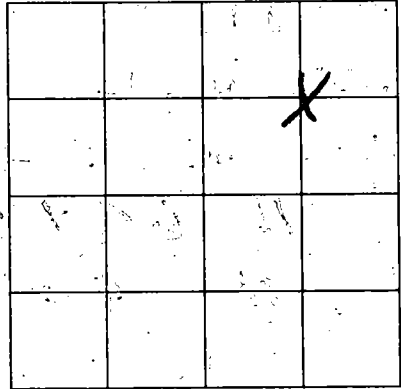

SECTION 18

Please indicate well location X.

ADDITIONAL INFORMATION

Multiple horizontal lines for additional information.

RECEIVED

© 2000 by the American Society of Professional Surveyors

If more than one screen, show location of each on sketch.