

MISSISSIPPI DEPARTMENT OF NATURAL RESOURCES
Bureau of Land and Water Resources

P.O. Box 10631
Jackson, Mississippi 39209
WATER WELL DRILLERS LOG

COUNTY WELL LOCATED
Harrison

WELL NUMBER CODED
H 2461

DATE WELL COMPLETED
12-9-87

PERMIT NUMBER

NAME OF DRILLING FIRM
M & B Drilling Co.

NAME & MAILING ADDRESS OF LANDOWNER
Pine Ridge Partnership
P.O. Box 308
Cullport, Miss. 39502

WELL LOCATION: SEC *19* TOWNSHIP *16* RANGE *S 18 W*

DISTANCE *3* Miles DIRECTION *NW* of NEAREST TOWN *Woodmarket*

OTHER LANDMARK

WELL PURPOSE: Home, Irrigation, Municipal, Industrial, Fish Pond, etc.
Home

PUMP DATA

PUMP TYPE (Circle One):
Submersible Turbine, Jet, Flowing Well,
Other (Describe)

POWER TYPE (Circle One):
Electric Tractor, Diesel, Gasoline, Butane,
Other (Describe)

Pump Capacity (GPM) *20* No. of Stages Setting Depth *100* FT.

PUMP TEST
Well yielded *20* GPM with
a drawdown of _____ ft.
after _____ hours of pumping

WELL DATA

Well Depth <i>340</i>	Casing Diameter (In.) <i>4" X 2"</i>	Casing Length (Ft.) <i>310</i>
Type of Casing <i>PVC</i>	Hole Depth <i>340</i>	Depth to Static Water Level <i>50</i>

TYPE OF COMPLETION: (Circle One or More):
Natural Development Gravel Packed, Underreamed, Telescoped,
Open Hole, Other (Describe)

Top of Lap Pipe or Reduction in Casing

FEET IF TELESCOPED OR MORE THAN ONE SCREEN: USE BACK PAGE

LOG DATA

TYPE OF LOG RUN (Circle One):
Electric, Gamma Ray, Density, Sonic, No Log Run, Neutron,
Other (Describe)

Name of Organization Running Log

SCREEN DATA

Diameter - Inches <i>2"</i>	Length - Feet <i>10</i>	Slot Size - Inches <i>1008</i>
Screen Type <i>PVC WOP</i>	Depth to Bottom - Feet <i>320</i>	

GEOLOGIC DATA (Office Use Only)

Surface Elev.	Geologic Unit	Unit Thickness	Depth to Top
Subs. SWL	Date	Analysis	Aquifer Test

Driller's Remarks

DESCRIPTION OF FORMATIONS ENCOUNTERED	FROM	TO
<i>Clay</i>	<i>0</i>	<i>20</i>
<i>Sand</i>	<i>20</i>	<i>40</i>
<i>Sand & Clay Breaks</i>	<i>40</i>	<i>120</i>
<i>Blue Clay</i>	<i>120</i>	<i>250</i>
<i>Grey Sand</i>	<i>250</i>	<i>320</i>
<i>Blue Clay</i>	<i>320</i>	<i>340</i>

RECEIVED

FEB 22 1988



Department of Natural Resources
Bureau of Land & Water Resources

FORMATIONS (continued)	FROM	TO

IF MORE SPACE IS NEEDED, USE BACK

If well telescopes please sketch and show depths.

GROUND LEVEL

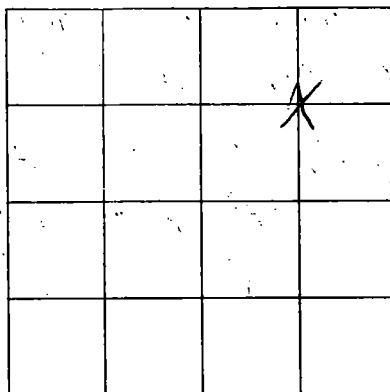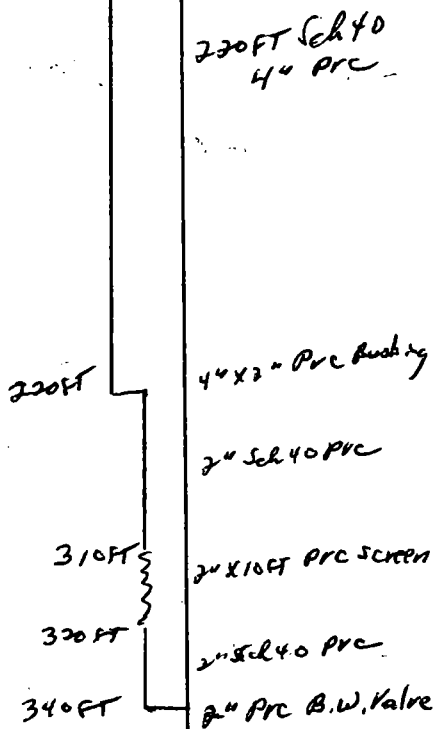

SECTION 19

Please indicate well location X.

ADDITIONAL INFORMATION

If more than one screen, show location of each on sketch.