

HARRISON
H2462

MISSISSIPPI DEPARTMENT OF NATURAL RESOURCES

Bureau of Land and Water Resources

Southport Mall

P.O. Box 10631

Jackson, Mississippi 39209

WATER WELL DRILLERS LOG

3-16-88 19
date well completed

R. J. Mooker
firm name

HARRISON
county well located

LANDOWNER: GERALD FARVE
Blow River Estates
Calhoun, MS
(mailing address)

description of formations encountered	from	to
TOP SOIL	0	20
White Sand	20	60
Blue clay	60	215
Coarse Sand	215	220
Blue clay	220	240
fine sand	240	260
Blue clay	260	440
Coarse Sand	440	480

WELL LOCATION:
sec. 31 T. 6 N. R. 10 E
2 1/2 miles W of LOULMANN
(distance) (direction) (nearest town)

WELL PURPOSE:
(home, irrigation, municipal, industrial)

WELL COMPLETION DATA:

- (1) diameter (inches) 2"
- (2) total depth (feet) 480'
- (3) static water level (feet) 58' ^{below} above top of ground.
- (4) casing PVC 480'
(material) (depth)
- _____ if telescope see back.
(size)
- (5) screen 10' 480'
(length) (depth to top)
- 2" PVC
(size) (material)
- (6) pump _____
(HP) (yield gpm)
- _____ (type power)
- (7) electric log _____
(yes or no)
- _____ (organization running log)
- (8) how well bottom plugged Bwme

DRILLERS REMARKS:


RECEIVED

MAR 31 1988

Department of Natural Resources
Bureau of Land & Water Resources

If well telescopes please sketch and show depths.

GROUND LEVEL

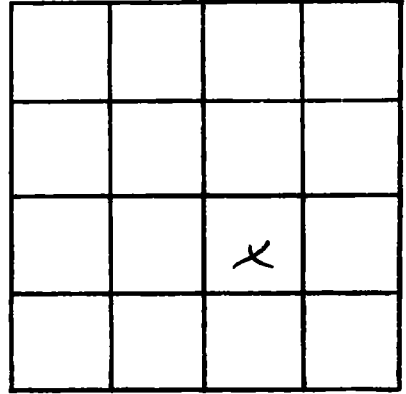

SECTION 31

Please indicate well location X.

ADDITIONAL INFORMATION

If more than one screen,
show locations of each on sketch.