

**MISSISSIPPI DEPARTMENT OF NATURAL RESOURCES**  
Bureau of Land and Water Resources

P.O. Box 10631  
Jackson, Mississippi 39209  
**WATER WELL DRILLERS LOG**

COUNTY WELL LOCATED  
*Harrison*

WELL NUMBER (CODED)  
*H 2866*

DATE WELL COMPLETED  
*Aug. 22. 1988*

PERMIT NUMBER  
*0239*

NAME OF DRILLING FIRM  
*Medall Pump & Well*

NAME & MAILING ADDRESS OF LANDOWNER  
*Steve Moore*

*8482 Mary St.*

*Bilau, ms.*

WELL LOCATION: SEC *27* TOWNSHIP *6* RANGE *10* <sup>N</sup> <sub>W</sub>

DISTANCE *8* Miles *North* of *Bilau*

OTHER LANDMARK

WELL PURPOSE  Home, Irrigation, Municipal, Industrial, Fish Pond, etc.

**PUMP DATA**

PUMP TYPE (Circle One):  
 Submersible Turbine, Jet, Flowing Well,  
Other (Describe) \_\_\_\_\_

POWER TYPE (Circle One):  
 Electric Tractor, Diesel, Gasoline, Butane,  
Other (Describe) \_\_\_\_\_

Pump Capacity (GPM) <i>18</i>	No. of Stages	Setting Depth <i>120'</i>	FT.
----------------------------------	---------------	------------------------------	-----

PUMP TEST

Well yielded *18* GPM with  
a drawdown of *15* ft.  
after *1* hours of pumping

**WELL DATA**

Well Depth <i>720'</i>	Casing Diameter (In.) <i>2" X 4"</i>	Casing Length (Ft.) <i>720'</i>
Type of Casing <i>PVC</i>	Hole Depth <i>730</i>	Depth to Static Water Level <i>80'</i>

TYPE OF COMPLETION: (Circle One or More):  
 Gravel Packed,  Underreamed,  Telescoped,  
 Natural Development,  Open Hole,  Other  
(Describe) \_\_\_\_\_

Top of Lap Pipe or Reduction in Casing

FEET  IF TELESCOPED OR MORE THAN ONE SCREEN: USE BACK PAGE

**LOG DATA**

TYPE OF LOG RUN (Circle One):  
Electric, Gamma Ray, Density, Sonic,  No Log Run, Neutron,  
Other (Describe) \_\_\_\_\_

Name of Organization Running Log

**SCREEN DATA**

Diameter - Inches <i>2"</i>	Length - Feet <i>20'</i>	Slot Size - Inches <i>.0006</i>
Screen Type	Depth to Bottom - Feet	

**GEOLOGIC DATA (Office Use Only)**

Surface Elev.	Geologic Unit	Unit Thickness	Depth to Top
Subs. SWL	Date	Analysis	Aquifer Test

Driller's Remarks

DESCRIPTION OF FORMATIONS ENCOUNTERED	FROM	TO	FORMATIONS (Continued)	FROM	TO
<i>mud</i>	<i>0</i>	<i>70</i>	<div style="font-size: 2em; font-weight: bold; opacity: 0.5;">RECEIVED</div> <p><i>SEP 14 1988</i></p> <p align="center">Department of Natural Resources Bureau of Land &amp; Water Resources</p>		
<i>Sand</i>	<i>70</i>	<i>110</i>			
<i>Mud</i>	<i>110</i>	<i>400</i>			
<i>Sand</i>	<i>400</i>	<i>420</i>			
<i>mud</i>	<i>420</i>	<i>510</i>			
<i>Sand</i>	<i>510</i>	<i>560</i>			
<i>mud</i>	<i>560</i>	<i>6600</i>			
<i>sand</i>	<i>6600</i>	<i>720</i>			


IF MORE SPACE IS NEEDED, USE BACK

If well telescopes please  
sketch and show depths.

GROUND LEVEL

200'-4"

520'-2"

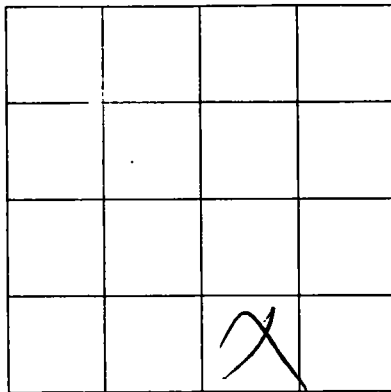

SECTION \_\_\_\_\_

Please indicate well location X.

ADDITIONAL INFORMATION

Multiple horizontal lines for writing additional information.

If more than one screen,  
show location of each on sketch.