

MISSISSIPPI DEPARTMENT OF NATURAL RESOURCES
Bureau of Land and Water Resources

P.O. Box 10631
Jackson, Mississippi 39209
WATER WELL DRILLERS LOG

COUNTY WELL LOCATED
Harrison

WELL NUMBER <u># 2487</u>	CODED
DATE WELL COMPLETED <u>5/20/88</u>	

PERMIT NUMBER
NAME OF DRILLING FIRM <u>Coast Water Well Serv.</u>

NAME & MAILING ADDRESS OF LANDOWNER <u>Chris Martin</u>		
<u>4314 Victoria Lane</u>		
<u>Bloomington</u>		
WELL LOCATION: SEC	TOWNSHIP	RANGE
<u>32</u>	<u>6 S</u>	<u>9 W</u>
DISTANCE <u>3</u> Miles	DIRECTION <u>North</u> of	NEAREST TOWN <u>Dioberville</u>
OTHER LANDMARK		
WELL PURPOSE: Home, Irrigation, Municipal, Industrial, Fish Pond, etc. <u>home</u>		

PUMP DATA		
PUMP TYPE (Circle One): Submersible, Turbine, <u>Jet</u> Flowing Well, Other (Describe) _____		
POWER TYPE (Circle One): <u>Electric</u> , Tractor, Diesel, Gasoline, Butane, Other (Describe) _____		
Pump Capacity (GPM) <u>14'</u>	No. of Stages <u>2</u>	Setting Depth <u>-</u> FT.
PUMP TEST		
Well yielded _____ GPM with a drawdown of _____ ft. after _____ hours of pumping		

WELL DATA		
Well Depth <u>187'</u>	Casing Diameter (In.) <u>2"</u>	Casing Length (Ft.) <u>172'</u>
Type of Casing <u>PVC</u>	Hole Depth <u>187'</u>	Depth to Static Water Level <u>25'</u>
TYPE OF COMPLETION: (Circle One or More): <u>Gravel Packed</u> , Underreamed, Telescoped, Natural Development, Open Hole, Other		
Top of Lap Pipe or Reduction in Casing FEET IF TELESCOPED OR MORE THAN ONE SCREEN: USE BACK PAGE		

LOG DATA			
TYPE OF LOG RUN (Circle One): Electric, Gamma Ray, Density, Sonic, <u>No Log Run</u> , Neutron, Other (Describe) _____			
Name of Organization Running Log			

SCREEN DATA		
Diameter - Inches <u>2"</u>	Length - Feet <u>10'</u>	Slot Size - Inches <u>.008</u>
Screen Type <u>PVC</u>	Depth to Bottom - Feet <u>182'</u>	

GEOLOGIC DATA (Office Use Only)			
Surface Elev.	Geologic Unit	Unit Thickness	Depth to Top
Subs. SWL	Date	Analysis	Aquifer Test


Driller's Remarks

DESCRIPTION OF FORMATIONS ENCOUNTERED	FROM	TO
<u>Top Soil</u>	<u>0</u>	<u>2</u>
<u>Blue Clay</u>	<u>2</u>	<u>25</u>
<u>White Gravel</u>	<u>25</u>	<u>60</u>
<u>Sand</u>		
<u>Blue Clay</u>	<u>60</u>	<u>160</u>
<u>Gray Mudsand</u>	<u>160</u>	<u>182</u>
<u>Blue Clay</u>	<u>182</u>	<u>187</u>

FORMATIONS CONTINUED FROM	TO
RECEIVED	
NOV 15 1988	
Department of Natural Resources Bureau of Land & Water Resources	
IF MORE SPACE IS NEEDED, USE BACK	

If well telescopes please sketch and show depths.

GROUND LEVEL

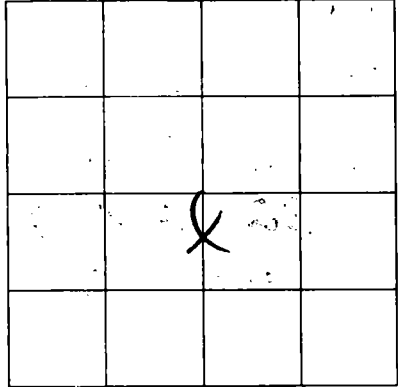

SECTION 32

Please indicate well location X.

ADDITIONAL INFORMATION

If more than one screen, show location of each on sketch.