

MISSISSIPPI DEPARTMENT OF NATURAL RESOURCES

Bureau of Land and Water Resources

P.O. Box 10631

Jackson, Mississippi 39209

WATER WELL DRILLERS LOG

COUNTY WELL LOCATED HARRISON	
WELL NUMBER H	CODED
2474	
DATE WELL COMPLETED 5 FEB 90	

PERMIT NUMBER 0-485
NAME OF DRILLING FIRM CORETEC

NAME & MAILING ADDRESS OF LANDOWNER Mrs. ZELMA FLETCHER		
144 LAMEY LANE		
Biloxi, Ms. 39532		
WELL LOCATION: SEC	TOWNSHIP	RANGE
7	6	9
	S	W
DISTANCE 15 Miles	DIRECTION NORTH of	NEAREST TOWN Biloxi
OTHER LANDMARK 2 MILES EAST OF WHITE PLAINS CHURCH		
WELL PURPOSE: Home, Irrigation, Municipal, Industrial, Fish Pond, etc. HOME		

PUMP DATA		
PUMP TYPE (Circle One): Submersible, Turbine, Jet Flowing Well, Other (Describe) _____		
POWER TYPE (Circle One): Electric Tractor, Diesel, Gasoline, Butane, Other (Describe) _____ H/P _____		
Pump Capacity (GPM) 20	No. of Stages 1	Setting Depth 60 FT.
PUMP TEST		
Well yielded 18 GPM with drawdown of 5 ft. after 1 hours of pumping		

WELL DATA		
Well Depth 75'	Casing Diameter (In.) 2"	Casing Length (Ft.) 65'
Type of Casing PVE	Hole Depth 125'	Depth to Static Water Level 5'
TYPE OF COMPLETION: (Circle One or More): Gravel Packed, Underreamed, Telescoped, Natural Development , Open Hole, Other (Describe) _____		
Top of Lap Pipe or Reduction in Casing FEET IF TELESCOPED OR MORE THAN ONE SCREEN: USE BACK PAGE		

LOG DATA	
TYPE OF LOG RUN (Circle One): No Log Run Electric, Gamma Ray, Density, Sonic, Neutron, Other (Describe) _____	
Name of Organization Running Log	

SCREEN DATA		
Diameter - Inches 2"	Length - Feet 10'	Slot Size - Inches 0.010
Screen Type PVE (SLOTTED)	Depth to Bottom - Feet 65'-75'	

GEOLOGIC DATA (Office Use Only)			
Surface Elev.	Geologic Unit	Unit Thickness	Depth to Top
Subs. SWL	Date	Analysis	Aquifer Test
Driller's Remarks			


DESCRIPTION OF FORMATIONS ENCOUNTERED	FROM	TO
TOP SOIL	0	1
MUD	1	5
COURSE WHITE SAND	5	35
GREY MUD	35	37
COURSE GREY SAND	37	81
BLUE GUMBO MUD	81	125
	3	

FORMATIONS (Continued)	FROM	TO
RECEIVED		
APR 05 1990		
Department of Natural Resources Bureau of Land & Water Resources		

IF MORE SPACE IS NEEDED, USE BACK

If well telescopes please sketch and show depths.

GROUND LEVEL

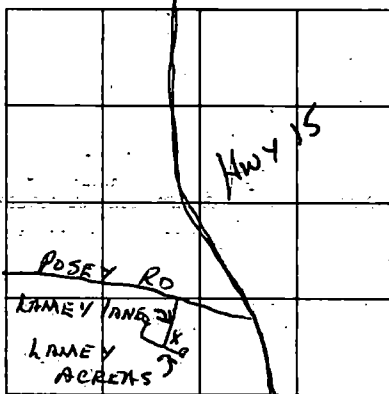

SECTION 7

Please indicate well location X.

ADDITIONAL INFORMATION

RECEIVED

Division of Land & Water Resources
Department of State of Resources

If more than one screen,
show location of each on sketch.