

MISSISSIPPI DEPARTMENT OF NATURAL RESOURCES

Bureau of Land and Water Resources

Southport Mall

P.O. Box 10631

Jackson, Mississippi 39209

WATER WELL DRILLERS LOG

Harrison
H
2475

374

Griner Drilling
Service, Inc.

Harrison

4-18-90 date well completed

firm name

county well located

LANDOWNER:

Mobil Oil E & P, SE, INC.
P.O. Box 51108 OCS
Lafayette, La. 70505
(mailing address)

description of formations encountered

from

to

clay

0 250

fine sand

250 270

clay

270 570

good coarse sand

570 650

WELL LOCATION: 2610'S + 1951'W

sec. 1 T. 6 N. R. 10 E. of NE/4

No. 1 A. U.S.A. miles (distance) of (direction) of (nearest town)

WELL PURPOSE: oilfield rig supply
(home, irrigation, municipal, industrial)

WELL COMPLETION DATA:

(1) diameter (inches) 4"

(2) total depth (feet) 650'

(3) static water level (feet) 35' below top of ground.

(4) casing PVC 630' (material) (depth)

4" (size) If telescopes see back

(5) screen 20' From 630' to 650' (length) (depth to top)

4" PVC slotted (size) (material)

(6) pump 7 1/2 100 (HP) (yield gpm)

230 volt 3 phase submersible

(7) electric log (yes or no)

(organization running log)

(8) how well bottom cleaned 4" plug & backwash valve

DRILLERS REMARKS:

No. 2

Water Well


RECEIVED

JUN 18 1990

Department of Natural Resources
Bureau of Land & Water Resources

If well telescopes please sketch and show depths.

GROUND LEVEL

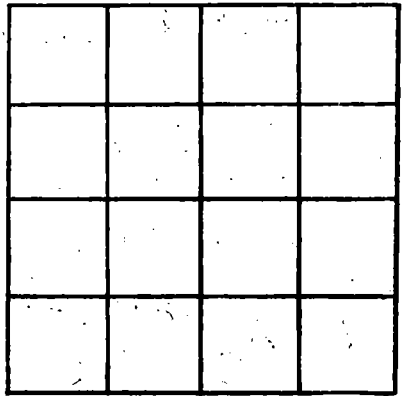

SECTION _____

Please indicate well location X.

ADDITIONAL INFORMATION

If more than one screen,
show locations of each on sketch.