

# MISSISSIPPI DEPARTMENT OF NATURAL RESOURCES

Bureau of Land and Water Resources

P.O. Box 10631

Jackson, Mississippi 39209

WATER WELL DRILLERS LOG

COUNTY WELL LOCATED  
*Harrison*

WELL NUMBER  
*H 2483*

CODED PERMIT NUMBER

DATE WELL COMPLETED  
*9/9/88*

NAME OF DRILLING FIRM  
*Celbith Drinkins*

ADDRESS  
*846 Wood Market Rd  
Baton Rouge 39532*

NAME & MAILING ADDRESS OF LANDOWNER  
*dean mac Byrd  
Joe Husty Rd  
Baton, Ms 39532*

WELL LOCATION: SEC TOWNSHIP RANGE  
*36 6 S 10 W*

DISTANCE DIRECTION NEAREST TOWN  
*Celbith 3 miles*

OTHER LANDMARK  
*Howard Creek*

WELL PURPOSE: Home, Irrigation, Municipal, Industrial, Fish Pond, etc.  
*Home*

PUMP DATA

PUMP TYPE (Circle One):  
Submersible, Turbine, Jet Flowing Well, Other (Describe) \_\_\_\_\_

POWER TYPE (Circle One):  
Electric, Tractor, Diesel, Gasoline, Butane, Other (Describe) \_\_\_\_\_

Pump Capacity (GPM) No. of Stages Setting Depth  
*10 2 60* FT.

PUMP TEST

Well yielded 10 GPM with a drawdown of 3 ft. after 6 hours of pumping

WELL DATA

Well Depth Casing Diameter (In.) Casing Length (Ft.)  
*270' 2" 260'*

Type of Casing Hole Depth Depth to Static Water Level  
*PVC 270' 40'*

TYPE OF COMPLETION: (Circle One or More):  
Natural Development, Gravel Packed, Underreamed, Telescoped, Open Hole, Other (Describe) \_\_\_\_\_

Top of Lap Pipe or Reduction in Casing  
FEET IF TELESKOPED OR MORE THAN ONE SCREEN: USE BACK PAGE

LOG DATA

TYPE OF LOG RUN (Circle One):  
No Log Run, Gamma Ray, Density, Sonic, Neutron, Other (Describe) \_\_\_\_\_

Name of Organization Running Log

SCREEN DATA

Diameter - Inches Length - Feet Slot Size - Inches  
*2" 10' .006*

Screen Type Depth to Bottom - Feet  
*PVC Saw 270'*

GEOLOGIC DATA (Office Use Only)

Surface Elev.	Geologic Unit	Unit Thickness	Depth to Top
Subs. SWL	Date	Analysis	Aquifer Test

Driller's Remarks  
*None*

DESCRIPTION OF FORMATIONS ENCOUNTERED	FROM	TO
<i>top soil</i>	<i>1</i>	<i>3</i>
<i>red clay</i>	<i>3</i>	<i>11</i>
<i>Coarse white sand</i>	<i>11</i>	<i>30</i>
<i>fine blue clay</i>	<i>30</i>	<i>110</i>
<i>hard blue clay</i>	<i>110</i>	<i>250</i>
<i>fine white sand</i>	<i>230</i>	<i>250</i>
<i>red white sand</i>	<i>250</i>	<i>270</i>

FORMATIONS ENCOUNTERED FROM TO

**RECEIVED**


MAR 15 1991

Dept. of Environmental Quality  
Bureau of Land & Water Resources

IF MORE SPACE IS NEEDED, USE BACK

If well telescopes please  
sketch and show depths.

GROUND LEVEL

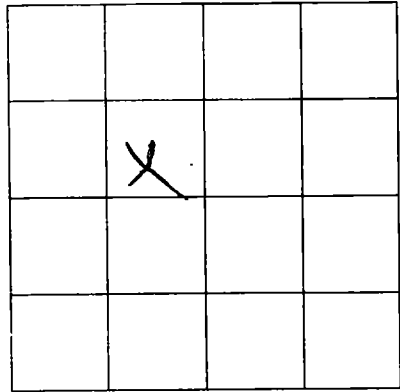

SECTION \_\_\_\_\_

Please indicate well location X.

ADDITIONAL INFORMATION

If more than one screen,  
show location of each on sketch.