

**MISSISSIPPI DEPARTMENT OF NATURAL RESOURCES**

Bureau of Land and Water Resources

P.O. Box 10631

Jackson, Mississippi 39209

**WATER WELL DRILLERS LOG**

COUNTY WELL LOCATED <i>Harrison</i>			
WELL NUMBER <i>H 2484</i>	CODED	PERMIT NUMBER <i>OK State Perkins</i>	NAME OF DRILLING FIRM <i>Ed School Market Rd</i>
DATE WELL COMPLETED <i>9/12/88</i>			
NAME & MAILING ADDRESS OF LANDOWNER <i>Kim Mopler</i> <i>Joe Park Rd</i> <i>Billot MS 39532</i>			
WELL LOCATION: SEC	TOWNSHIP	RANGE	
<i>32</i>	<i>6</i>	<i>9</i>	<i>W</i>
DISTANCE	DIRECTION	NEAREST TOWN	
<i>2</i>	<i>East</i>	<i>Daysburg</i>	
OTHER LANDMARK <i>MS power Co. Line</i>			
WELL PURPOSE: Home, Irrigation, Municipal, Industrial, Fish Pond, etc. <i>Home</i>			

PUMP DATA		
PUMP TYPE (Circle One): Submersible, Turbine, <input checked="" type="radio"/> Jet, Flowing Well, Other (Describe) _____		
POWER TYPE (Circle One): <input checked="" type="radio"/> Electric, Tractor, Diesel, Gasoline, Butane, Other (Describe) _____		
Pump Capacity (GPM) <i>10</i>	No. of Stages <i>2</i>	Setting Depth <i>50'</i> FT.
PUMP TEST		
Well yielded <i>10</i> GPM with a drawdown of <i>3</i> ft. after <i>6</i> hours of pumping		

WELL DATA		
Well Depth <i>230'</i>	Casing Diameter (In.) <i>4 1/2"</i>	Casing Length (Ft.) <i>220'</i>
Type of Casing <i>PC</i>	Hole Depth <i>230</i>	Depth to Static Water Level <i>30'</i>
TYPE OF COMPLETION: (Circle One or More): <input checked="" type="checkbox"/> Gravel Packed, <input type="checkbox"/> Underreamed, <input type="checkbox"/> Telescoped, <input checked="" type="checkbox"/> Natural Development, <input type="checkbox"/> Open Hole, <input type="checkbox"/> Other (Describe) _____		
Top of Lap Pipe or Reduction in Casing  FEET <input type="checkbox"/> IF TELESCOPED OR MORE THAN ONE SCREEN: USE BACK PAGE		

LOG DATA	
TYPE OF LOG RUN (Circle One): Electric, Gamma Ray, Density, Sonic, <input checked="" type="radio"/> No Log Run, Neutron, Other (Describe) _____	
Name of Organization Running Log	

SCREEN DATA		
Diameter - Inches <i>2"</i>	Length - Feet <i>10'</i>	Slot Size - Inches <i>.006</i>
Screen Type <i>PC 50W</i>	Depth to Bottom - Feet <i>230'</i>	


GEOLOGIC DATA (Office Use Only)			
Surface Elev.	Geologic Unit	Unit Thickness	Depth to Top
Subs. SWL	Date	Analysis	Aquifer Test
Driller's Remarks  <i>None</i>			

DESCRIPTION OF FORMATIONS ENCOUNTERED	FROM	TO
<i>Top Soil</i>	<i>1</i>	<i>3</i>
<i>Red Clay</i>	<i>3</i>	<i>10</i>
<i>White Sand</i>	<i>10</i>	<i>35</i>
<i>Soft Blue Clay</i>	<i>35</i>	<i>70</i>
<i>Hard Blue Clay</i>	<i>70</i>	<i>95</i>
<i>fine white sand</i>	<i>95</i>	<i>210</i>
<i>Coarse white sand</i>	<i>210</i>	<i>230</i>

FORMATIONS (Continued)	FROM	TO
<b>RECEIVED</b>		
MAR 15 1991		
Dept. of Environmental Quality Bureau of Land & Water Resources		
IF MORE SPACE IS NEEDED, USE BACK		

If well telescopes please  
sketch and show depths.

GROUND LEVEL

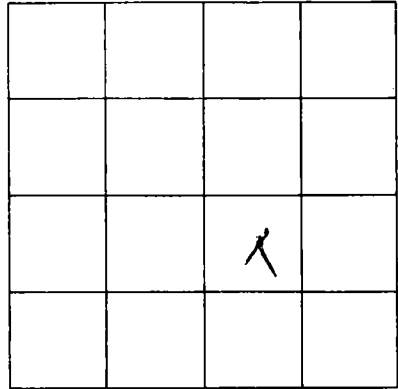

SECTION \_\_\_\_\_

Please indicate well location X.

ADDITIONAL INFORMATION

If more than one screen,  
show location of each on sketch.