

**MISSISSIPPI DEPARTMENT OF ENVIRONMENTAL QUALITY**  
Bureau of Land and Water Resources

P. O. Box 10631  
Jackson, MS 39289-0631  
**WATER WELL DRILLERS LOG**

COUNTY WELL LOCATED <i>N Harrison</i>	
WELL NUMBER <i>H 2517</i>	CODED
DATE WELL COMPLETED <i>4-11-89</i>	

PERMIT NUMBER
NAME OF DRILLING CONTRACTOR <b>Coastal Drilling &amp; Service Co.</b> <b>8456 Woolmarket Biloxi Road</b> <b>Biloxi, Mississippi 39532</b>

NAME & MAILING ADDRESS OF LANDOWNER <i>Wright Construction Comp.</i> <i>27869 Lorraine Road</i> <i>Belzoni Ms.</i>			
WELL LOCATION <i>N Harrison</i>	SEC <i>33</i>	TOWNSHIP <i>6 N</i>	RANGE <i>10 E</i>
DISTANCE <i>1/2</i> Miles	DIRECTION <i>N</i>	NEAREST TOWN <i>Woolmarket</i>	
OTHER LANDMARK <i>Ms Power line</i>			
WELL PURPOSE: Home Irrigation, Municipal, Industrial, Fish Pond, etc. <i>Home</i>			

<b>PUMP DATA</b>		
PUMP TYPE (Circle One): Submersible, Turbine, <u>Jet</u> Flowing Well, Other (Describe) _____		
POWER TYPE (Circle One): <u>Electric</u> Tractor, Diesel, Gasoline, Butane, Other (Describe) _____ H/P _____		
Pump Capacity (GPM) <i>12</i>	No. of Stages <i>3</i>	Setting Depth <i>60</i> FT.
PUMP TEST Well yielded _____ <i>12</i> GPM with a drawdown of _____ <i>0</i> ft. after _____ <i>5</i> hours of pumping		

<b>WELL DATA</b>		
Well Depth <i>460'</i>	Casing Diameter (In.) <i>2"</i>	Casing Length (Ft.) <i>450'</i>
Type of Casing <i>PVC</i>	Hole Depth <i>460'</i>	Depth to Static Water Level <i>40'</i>
TYPE OF COMPLETION: (Circle One or More): Gravel Packed, Underreamed, Telescoped, <u>Natural Development</u> , Open Hole, Other (Describe) _____		
Top of Lap Pipe or Reduction in Casing  FEET <input type="checkbox"/> IF TELESCOPED OR MORE THAN ONE SCREEN: USE BACK PAGE		

<b>LOG DATA</b>	
TYPE OF LOG RUN (Circle One): No Log Run, Electric, Gamma Ray, Density, Sonic, Neutron, Other (Describe) _____	
Name of Organization Running Log	

<b>SCREEN DATA</b>		
Diameter - Inches <i>2"</i>	Length - Feet <i>10'</i>	Slot Size - Inches <i>.008</i>
Screen Type <i>PVC</i>	Depth to Bottom - Feet <i>460'</i>	

<b>GEOLOGIC DATA (Office Use Only)</b>			
Surface Elev.	Geologic Unit	Unit Thickness	Depth to Top
Subs. SWL	Date	Analysis	Aquifer Test


Driller's Remarks  <i>None</i>
--------------------------------------

DESCRIPTION OF FORMATIONS ENCOUNTERED	FROM	TO	FORMATIONS (Continued)	FROM	TO
<i>top soil</i>	<i>1'</i>	<i>3'</i>	<b>RECEIVED</b>  FEB 24 1992  Dept. of Environmental Quality Bureau of Land & Water Resources		
<i>Red sand</i>	<i>3'</i>	<i>12'</i>			
<i>White sand</i>	<i>12'</i>	<i>28'</i>			
<i>soft Blue clay</i>	<i>28'</i>	<i>80'</i>			
<i>hard Blue clay</i>	<i>80'</i>	<i>260'</i>			
<i>fine water sand</i>	<i>260'</i>	<i>300'</i>			
<i>hard Blue clay</i>	<i>300'</i>	<i>410'</i>			
<i>fine water sand</i>	<i>410'</i>	<i>440'</i>			
<i>Coarse water sand</i>	<i>440'</i>	<i>460'</i>			
			IF MORE SPACE IS NEEDED, USE BACK		

If well telescopes please sketch and show depths

COSECO  
WELL LOG

GROUND LEVEL

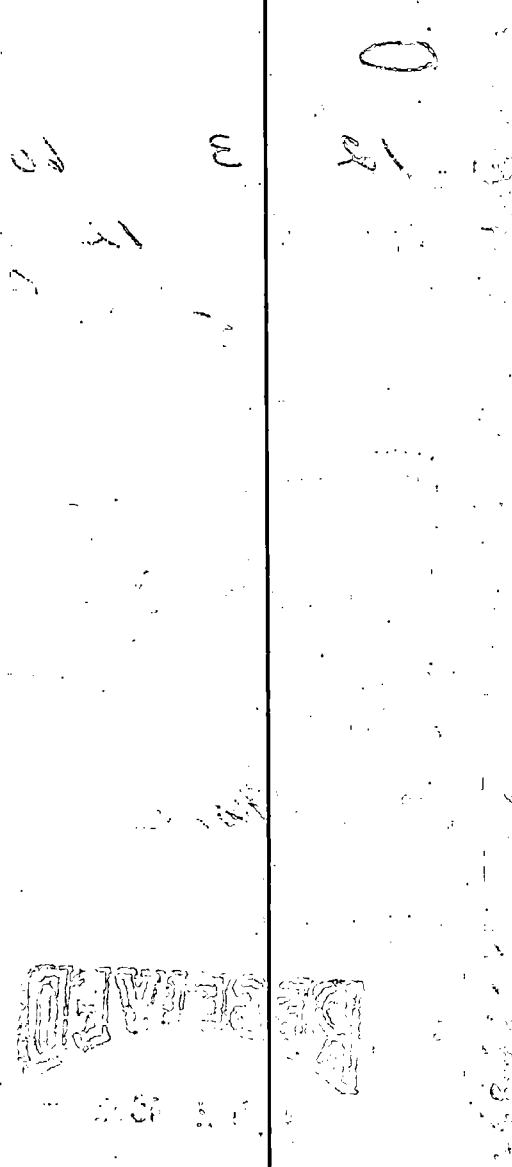


SECTION \_\_\_\_\_

Please indicate well location X

ADDITIONAL INFORMATION

Handwritten notes and lines in the additional information section.

REMAINED

If more than one screen, show location of each on sketch.