

**MISSISSIPPI DEPARTMENT OF ENVIRONMENTAL QUALITY**  
Bureau of Land and Water Resources

P. O. Box 10631  
Jackson, MS 39289-0631  
**WATER WELL DRILLERS LOG**

COUNTY WELL LOCATED <i>Madison</i>	
WELL NUMBER <b>H</b>	CODED
<b>2575</b>	
DATE WELL COMPLETED <b>10-10-92</b>	

PERMIT NUMBER <i>0-2039</i>
NAME OF DRILLING FIRM <i>McCall</i>

NAME & MAILING ADDRESS OF LANDOWNER <i>Allen Road</i>			
<i>Allen Rd.</i>			
<i>Mad. MS</i>			
WELL LOCATION:	SEC	TOWNSHIP	RANGE
	<b>18</b>	<b>4 N S</b>	<b>10 E W</b>
DISTANCE	DIRECTION	NEAREST TOWN	
OTHER LANDMARK			
WELL PURPOSE: <input checked="" type="checkbox"/> Home, <input type="checkbox"/> Irrigation, <input type="checkbox"/> Municipal, <input type="checkbox"/> Industrial, <input type="checkbox"/> Fish Pond, etc.			

PUMP DATA		
PUMP TYPE (Circle One): Submersible, Turbine, <u>Jet</u> Flowing Well, Other (Describe) _____		
POWER TYPE (Circle One): Electric, Tractor, Diesel, Gasoline, Butane, Other (Describe) _____ H/P <u>1</u>		
Pump Capacity (GPM) <b>2</b>	No. of Stages <b>15</b>	Setting Depth <b>40</b> FT.
PUMP TEST		
Well yielded <b>12</b> GPM with a drawdown of _____ ft. after <b>1</b> hours of pumping		

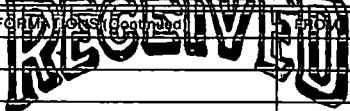
WELL DATA		
Well Depth <b>200</b>	Casing Diameter (In.) <b>2</b>	Casing Length (Ft.) <b>20</b>
Type of Casing <b>PVC</b>	Hole Depth <b>200</b>	Depth to Static Water Level <b>20</b>
TYPE OF COMPLETION: (Circle One or More): <input checked="" type="checkbox"/> Gravel Packed, <input type="checkbox"/> Underreamed, <input type="checkbox"/> Telescoped, <input checked="" type="checkbox"/> Natural Development, <input type="checkbox"/> Open Hole, <input type="checkbox"/> Other (Describe) _____		
Top of Lap Pipe or Reduction in Casing		
FEET IF TELESCOPED OR MORE THAN ONE SCREEN: USE BACK PAGE		

LOG DATA	
TYPE OF LOG RUN (Circle One): Electric, Gamma Ray, Density, Sonic, Neutron, Other (Describe) _____ <u>No Log Run</u>	
Name of Organization Running Log	

SCREEN DATA		
Diameter - Inches <b>2</b>	Length - Feet <b>10</b>	Slot Size - Inches <b>0006</b>
Screen Type <b>PVC</b>	Depth to Bottom - Feet <b>210</b>	

GEOLOGIC DATA (Office Use Only)			
Surface Elev.	Geologic Unit	Unit Thickness	Depth to Top
Subs. SWL	Date	Analysis	Aquifer Test

Driller's Remarks

DESCRIPTION OF FORMATIONS ENCOUNTERED	FROM	TO	FOOTING (Optional)	SPACING (Optional)	TO
 <b>OCT 07 1992</b> <b>Dept. of Environmental Quality</b> <b>Bureau of Land &amp; Water Resources</b>					
IF MORE SPACE IS NEEDED, USE BACK					

If well telescopes please sketch and show depths.

GROUND LEVEL


SECTION \_\_\_\_\_

Please indicate well location X.

ADDITIONAL INFORMATION

If more than one screen,  
show location of each on sketch.