

## Office of Land and Water Resources

**Jackson, MS 39289-0631**

# WATER WELL DRILLERS LOG

COUNTY WELL LOCATED	
<i>Hickson</i>	
WELL NUMBER	CODED
<i>H 2481</i>	<i>632</i>
DATE WELL COMPLETED	
<i>3-11-99</i>	

PERMIT NUMBER

NAME OF DRILLING FIRM

East Water Well  
Service

NAME & MAILING ADDRESS OF LANDOWNER  
Sammy Handler  
Hudson Krohn Rd.  
Beloxi Mrs 39532

WELL LOCATION: SEC 36 TOWNSHIP 6 RANGE 10  
DISTANCE 4 MILES DIRECTION NORTH NEAREST TOWN Beloxi

OTHER LANDMARK

WELL PURPOSE (Home) Irrigation, Municipal, Industrial, Fish Pond, etc.

### PUMP DATA

PUMP TYPE (Circle One):  
Submersible, Turbine, Jet, Flowing Well,  
Other (Describe) \_\_\_\_\_

POWER TYPE (Circle One):  
Electric, Tractor, Diesel, Gasoline, Butane,  
Other (Describe) \_\_\_\_\_  
H/P

Pump Capacity (GPM)	No. of Stages	Setting Depth
7.5	2	FT.

## PUMP TEST

Well yielded \_\_\_\_\_ GPM with  
a drawdown of \_\_\_\_\_ ft.  
after \_\_\_\_\_ hours of pumping

## WELL DATA

Well Depth 316'	Casing Diameter (In.) 2"	Casing Length (Ft.) 306'
Type of Casing PVC	Hole Depth 316'	Depth to Static Water Level 45'
TYPE OF COMPLETION: (Circle One or More): Gravel Packed, Underreamed, Telescoped, <u>Natural Development</u> , Open Hole, Other (Describe)		

## LOG DATA

TYPE OF LOG RUN (Circle One): No Log Run.  
 Electric, Gamma Ray, Density, Sonic, Neutron,  
 Other (Describe) \_\_\_\_\_  
 \_\_\_\_\_  
 Name of Organization Running Log \_\_\_\_\_

**GEOLOGIC DATA (Office Use Only)**

Surface Elev.	Geologic Unit	Unit Thickness	Depth to Top
Subs. SWL	Date	Analysis	Aquifer Test

WELL GROUTED TO A DEPTH OF 10 FEET  
Type Grout (circle one): Cement, Bentonite, or Mix

### SCREEN DATA


Diameter - Inches 2"	Length - Feet 10'	Slot Size - Inches .008
Screen Type PVC		Depth to Bottom - Feet 316

## Driller's Remarks


[illegible]

If well telescopes please  
sketch and show depths.

GROUND LEVEL

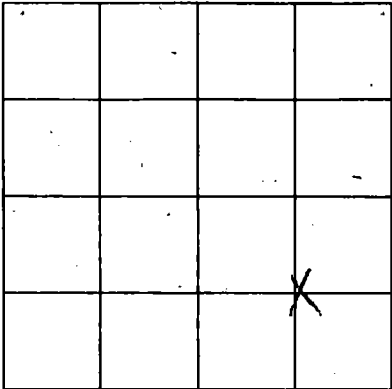

SECTION 36

Please indicate well location X.

ADDITIONAL INFORMATION

If more than one screen,  
show location of each on sketch.