

Harrison

MISSISSIPPI DEPARTMENT OF ENVIRONMENTAL QUALITY

Office of Land and Water Resources

P. O. Box 10631 Jackson, MS 39289-0631

WATER WELL DRILLERS LOG

COUNTY WELL LOCATED
 JACKSON
 WELL NUMBER
 H2113
 676
 DATE WELL COMPLETED
 9-24-99

PERMIT NUMBER
 NAME OF DRILLING FIRM
 Coast Water Well Service

NAME & MAILING ADDRESS OF LANDOWNER
 Sam Wright
 Roberts Rd
 Biloxi Ms
 WELL LOCATION SEC 29 TOWNSHIP 6 RANGE 10
 DISTANCE 6 Miles DIRECTION NORTH of NEAREST TOWN Biloxi
 OTHER LANDMARK
 WELL PURPOSE Agric. Irrigation, Municipal, Industrial, Fish Pond, etc.

PUMP DATA
 PUMP TYPE (Circle One): Submersible, Turbine, Jet, Flowing Well, Other (Describe)
 POWER TYPE (Circle One): Electric, Tractor, Diesel, Gasoline, Butane, Other (Describe) H/P 2
 Pump Capacity (GPM) 7 No. of Stages 3 Setting Depth FT.
 PUMP TEST
 Well yielded _____ GPM with a drawdown of _____ ft. after _____ hours of pumping

WELL DATA
 Well Depth 400' Casing Diameter (In.) 2" Casing Length (Ft.) 390'
 Type of Casing PVC Hole Depth 400' Depth to Static Water Level 105'

LOG DATA
 TYPE OF LOG RUN (Circle One): No Log Run, Electric, Gamma Ray, Density, Sonic, Neutron, Other (Describe)
 Name of Organization Running Log

TYPE OF COMPLETION: (Circle One or More): Gravel Packed, Underreamed, Telescoped, Natural Development, Open Hole, Other (Describe)
 WELL GROUTED TO A DEPTH OF 20 FEET
 Type Grout (circle one): Cement, Bentonite, or Mix

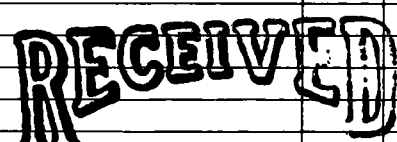
GEOLOGIC DATA (Office Use Only)

Surface Elev.	Geologic Unit	Unit Thickness	Depth to Top
Subs. SWL	Date	Analysis	Aquifer Test

SCREEN DATA
 Diameter - Inches 2" Length - Feet 10' Slot Size - Inches .008
 Screen Type PVC Depth to Bottom - Feet 400'

Driller's Remarks
 Top of Lap Pipe or Reduction in Casing
 FEET IF TELESCOPED OR MORE THAN ONE SCREEN: USE BACK PAGE

DESCRIPTION OF FORMATIONS ENCOUNTERED	FROM	TO
Top Soil	0	3
Orange Red Clay	3	40
Coarse Sand	40	50
Blue Clay Sh. sand	50	250
Low Med. density Clay	250	280
Blue Clay Sh. sand	280	360
Coarse Sand	360	400

FORMATIONS (Continued)	FROM	TO
 DEC 28 1999 Dept. of Environmental Quality Office of Land & Water Resources		

IF MORE SPACE IS NEEDED, USE BACK

If well telescopes please sketch and show depths.

GROUND LEVEL

X			

SECTION

29

Please indicate well location X.

ADDITIONAL INFORMATION

REGISTERED

070 1 1 1933

Dept of Land & Water Resources
1000 Lakeshore Blvd W

If more than one screen,
show location of each on sketch.