




If well telescopes please sketch and show depths.

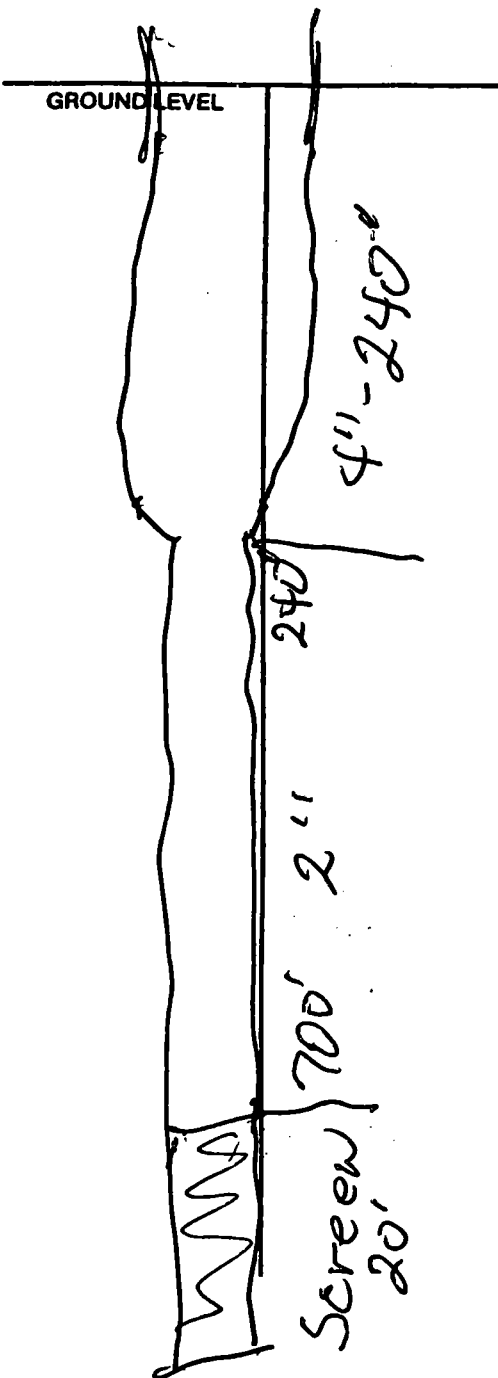

If more than one screen, show location of each on sketch.

|  |   |  |  |
|--|---|--|--|
|  |   |  |  |
|  |   |  |  |
|  | X |  |  |
|  |   |  |  |

SECTION 8

Please indicate well location X.

| Pump Capacity (GPM) | No. of Stages | Setting Depth |
|---------------------|---------------|---------------|
| 15                  | 13            | 160 FT.       |

PUMP TEST  
 Well yielded 35 GPM with  
 a drawdown of \_\_\_\_\_ ft.  
 after \_\_\_\_\_ hours of pumping

**LOG DATA**

TYPE OF LOG RUN (Circle One): No Log Run, Electric, Gamma Ray, Density, Sonic, Neutron, Other (Describe) \_\_\_\_\_

Name of Organization Running Log \_\_\_\_\_

**GEOLOGIC DATA (Office Use Only)**

| Surface Elev. | Geologic Unit | Unit Thickness | Depth to Top |
|---------------|---------------|----------------|--------------|
| Subs. SWL     | Date          | Analysis       | Aquifer Test |

Driller's Remarks  
 \_\_\_\_\_  
 \_\_\_\_\_  
 \_\_\_\_\_  
 \_\_\_\_\_