

MISSISSIPPI DEPARTMENT OF NATURAL RESOURCES

Bureau of Land and Water Resources

Southport Mall

P.O. Box 10631

Jackson, Mississippi 39209

WATER WELL DRILLERS LOG
COASTAL DRILLING & SERVICE CO.

ROUTE 1 BOX 618

Harrison
county well located

DIXON, MISS. 39532

Harrison
H
3-24-81

3/24/81 19
date well completed

LANDOWNER:

Bob McElton

description of formations encountered

from

to

Bob McElton

Bob McElton

(mailing address)

<i>Top Soil</i>	<i>1</i>	<i>3</i>
<i>Red Clay</i>	<i>3</i>	<i>16</i>
<i>Sugar Sand</i>	<i>16</i>	<i>30</i>
<i>Coarse white sand</i>	<i>30</i>	<i>45</i>
<i>Soft Blue Clay</i>	<i>45</i>	<i>60</i>
<i>Coarse white sand</i>	<i>60</i>	<i>80</i>
<i>Soft Blue Clay</i>	<i>80</i>	<i>230</i>
<i>Hard Blue Clay</i>	<i>230</i>	<i>270</i>
<i>fine white sand</i>	<i>270</i>	<i>310</i>
<i>Coarse white sand</i>	<i>310</i>	<i>345</i>

WELL LOCATION:


sec 25 T 6 N R 10 E
S W
M-R miles (distance) of (direction) of (nearest town)

WELL PURPOSE:

(home, irrigation, municipal, industrial)

WELL COMPLETION DATA:

- (1) diameter (inches) 4 1/2"
- (2) total depth (feet) 345'
- (3) static water level (feet) 70' below top of ground
- (4) casing 4 1/2" (material) 330' (depth)
- (5) screen 15' (length) 330' (depth to top)
- (6) pump 2" (size) 20 (HP) 20 (yield gpm)
- (7) electric log no (yes or no)

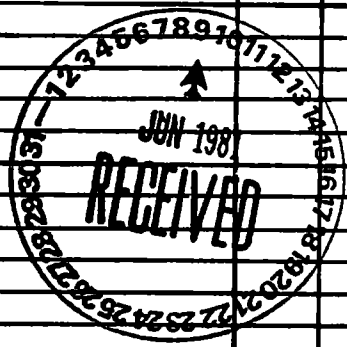

(organization running log)

(8) how well bottom plugged

2' bed with valve

DRILLERS REMARKS:

19-B

If well telescopes please sketch and show depths.

GROUND LEVEL

160' 4" PVC
Caseing

170' 2" PVC Caseing

15' 2" PVC Screen
2' Wash Valve

19-13

If more than one screen,
show locations of each on sketch.

X			

SECTION

Please indicate well location X.

ADDITIONAL INFORMATION

5-70

20

10

555

20

555

20

