

HAR.

**CODED**

J

**WATER WELL DRILLERS LOG**

J-316

6-11-62

Date: 6-11, 1962, Driller: Sutter Well Works County Harrison

(Name)

(1) Owner of Land: Nerb Shaddy  
(Name)

He Liala Miss.  
(Address)

(2) Location: SE 1/4, NW 1/4, Sec. 34 T 75 R 13 W

1 miles NW of He Liala  
(distance) (direction) (Nearest Town)

(3) Topography: Hilly  
(Hilly) (Flat) (Level)

(4) Purpose of Well: domestic  
(Domestic Irrigation  
Municipal, Industrial, Other)

Description & Color of Materials  
Sand, Clay, Red Clay, Shell, etc.

Thick-  
ness  
Feet

Depth  
Feet

Original well 270'  
pulled out - drilling:

Clay 215 485-  
sand 66 551

**Information upon completion of well:**

(1) Diameter 2 inches.

(2) Total Depth 551 feet.

(3) Water Level 23 feet below top of ground.

(4) Cased to cell, Size 2"

(5) Screen: Size 2", Length 5'

(6) Were any formations sealed against pollution?


no

If YES depth of formation \_\_\_\_\_

Why \_\_\_\_\_

Drillers Remarks: \_\_\_\_\_

**CODED**

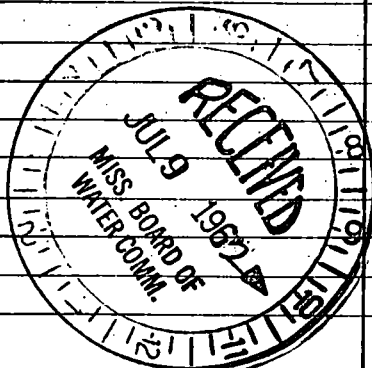

(Use Back Side)

Well No.

18  
31

Handwritten notes at the top of the page, including "The first three lines" and "The first three lines" written twice.

Handwritten notes in the middle section, including "The first three lines" and "The first three lines" written multiple times.

Handwritten notes in the lower middle section, including "The first three lines" and "The first three lines" written multiple times.

Handwritten notes in the lower section, including "The first three lines" and "The first three lines" written multiple times.

Handwritten notes in the lower section, including "The first three lines" and "The first three lines" written multiple times.

Handwritten notes in the lower section, including "The first three lines" and "The first three lines" written multiple times.

Handwritten notes at the bottom of the page, including "The first three lines" and "The first three lines" written multiple times.