

J-308

J5
10-5-61

Q461704

WATER WELL DRILLERS LOG

CODED

J-309

Date: 10-5, 1961, Driller: Butter Well Works County Harrison
(Name)

- (1) Owner of Land: Herb Shaddy
(Name)
Mc Lisle, Miss.
(Address)
- (2) Location: 1/4, 1/4, Sec. 34 T7 R13,
1 miles NW of McLisle,
(distance) (direction) (Nearest Town)
- (3) Topography: Hilly
(Hilly) (Flat) (Level)
- (4) Purpose of Well: domestic
(Domestic Irrigation
Municipal, Industrial, Other)


Description & Color of Materials Sand, Clay, Red Clay, Shell, etc.	Thick- ness Feet	Depth Feet
<u>red clay</u>	<u>18</u>	<u>18</u>
<u>red sand</u>	<u>117</u>	<u>135</u>
<u>Clay</u>	<u>113</u>	<u>248</u>
<u>sand</u>	<u>22</u>	<u>270</u>

Information upon completion of well:

- (1) Diameter 2 inches.
- (2) Total Depth 270 feet.
- (3) Water Level 50 feet below top of ground.
- (4) Cased to all, Size 2"
- (5) Screen: Size 2", Length 5'
- (6) Were any formations sealed against pollution?
no


If YES depth of formation _____
Why _____
Drillers Remarks: _____

CODED

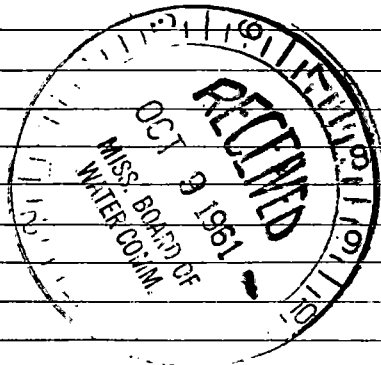

(Use Back Side)

Well No.

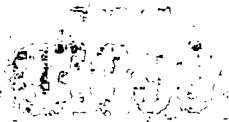

Faint, illegible text at the top of the page, possibly a header or title.

Faint, illegible text in the upper left quadrant.

Faint, illegible text in the upper right quadrant.

Main body of faint, illegible text, possibly a list or series of entries.

Bottom section of faint, illegible text, possibly a footer or concluding remarks.