

K308

RJB Q458507

9-12-61

WATER WELL DRILLERS LOG

CODED

Date: 9-12, 1961, Driller: Sutter Well Wks. County Harrison
 (Name)

(1) Owner of Land:	Description & Color of Materials Sand, Clay, Red Clay, Shell, etc.	Thick- ness Feet	Depth Feet
<u>Herbert J Ladner</u> <small>(Name)</small>			
<u>Rt. 1</u> <u>Pass Christian</u> <small>(Address)</small>	<u>red clay</u> <u>sand</u>	<u>20</u> <u>89</u>	<u>20</u> <u>109</u>
(2) Location: <u>1/4</u> , <u>1/4</u> , Sec. <u>13</u> T <u>7</u> R <u>13</u> <u>13</u> miles <u>NE</u> of <u>Pass Christian</u> <small>(distance) (direction) (Nearest Town)</small>			
(3) Topography: <u>hilly</u> <small>(Hilly) (Flat) (Level)</small>			
(4) Purpose of Well: <u>domestic</u> <small>(Domestic Irrigation Municipal, Industrial, Other)</small>			

CODED


Information upon completion of well:

- (1) Diameter 2 inches.
- (2) Total Depth 109 feet.
- (3) Water level 31 feet below top of ground.
- (4) Cased to all, Size 2"
- (5) Screen: Size 2", Length 5'
- (6) Were any formations sealed against pollution?
 yes, no.

If YES depth of formation _____

Why _____

Drillers Remarks: _____

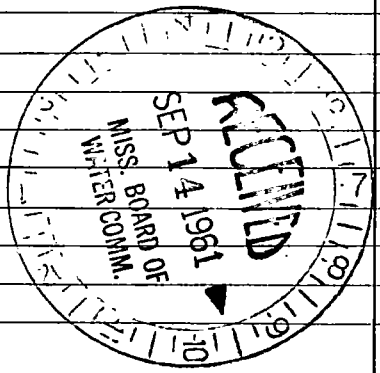

(Use Back Side)

Well No.

1950