

HAR.
J9

MISSISSIPPI BOARD OF WATER COMMISSIONERS

3-29-61

WATER WELL DRILLERS LOG

~~J-304~~ J-304

Date: 3-29, 1961, Driller: L Beard County Harrison

(Name)

(1) Owner of Land:	Description & Color of Materials Sand, Clay, Red Clay, Shell, etc.	Thick- ness Feet	Depth Feet
<u>Eddie Clark</u> (Name)	<u>Red Clay</u>		<u>10</u>
<u>Rt 1 Dan Christian Mrs</u> (Address)	<u>" Sand to</u>	<u>1</u>	<u>05</u>
(2) Location: <u>Near Allen Grocery</u> 1/4, 1/4, Sec. 1, R. 1	<u>Blue Clay</u>	<u>3</u>	<u>00</u>
<u>2</u> miles <u>North</u> , of <u>Delisle</u> (distance) (direction) (Nearest Town)	<u>water sandy</u> <u>total</u>		<u>15</u>
(3) Topography: _____ (Hilly) <input checked="" type="checkbox"/> (Flat) (Level)			
(4) Purpose of Well: <u>Home use</u> (Domestic Irrigation Municipal, Industrial, Other)			


Information upon completion of well:

- (1) Diameter 2" x 1 1/4" inches.
- (2) Total Depth 315 feet.
- (3) Water Level small flow feet below top of ground.
- (4) Cased to _____, Size _____
- (5) Screen: Size _____, Length _____
- (6) Were any formations sealed against pollution?
_____ yes, _____ no.

If YES depth of formation _____

Why _____

Drillers Remarks: _____

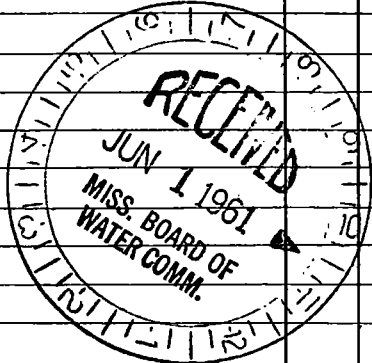

(Use Back Side)

Well No.

