

AJ 10
10-29-63

A 6456804

WATER WELL DRILLERS LOG

CODED

Date: 10-29, 1963, Driller: Hattisburg Butcher County Jackson
(Name)

(1) Owner of Land: Woodrow Bell
(Name)
Rt 1 Gulfport Miss
Wolf River area
(Address)
(2) Location: 1/4, 1/4, Sec. 1 T7R13
_____ miles _____ of _____
(distance) (direction) (Nearest Town)
(3) Topography: _____
(Hilly) (Flat) (Level)
(4) Purpose of Well: domestic
(Domestic Irrigation
Municipal, Industrial, Other)


Description & Color of Materials Sand, Clay, Red Clay, Shell, etc.	Thick- ness Feet	Depth Feet
<u>yellow clay</u>	<u>0-8</u>	
<u>white sand</u>	<u>8-19</u>	
<u>Blue clay</u>	<u>19-184</u>	
<u>blue sand</u>	<u>184-196</u>	
<u>blue clay</u>	<u>197-202</u>	
CODED		

Information upon completion of well:

(1) Diameter 2 inches.
(2) Total Depth 202 feet.
(3) Water Level 17 feet below top of ground.
(4) Cased to _____, Size _____
(5) Screen: Size 2", Length 10'
(6) Were any formations sealed against pollution?
_____ yes, _____ no.

If YES depth of formation _____
Why _____

Drillers Remarks: _____

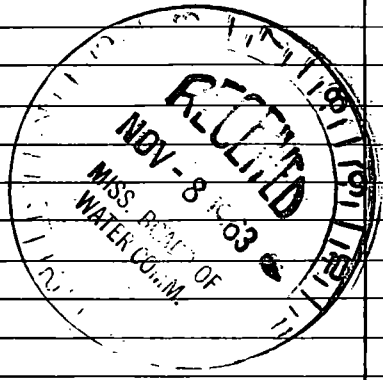

(Use Back Side)

Well No.

