

HAR.

MISSISSIPPI BOARD OF WATER COMMISSIONERS

J 13

J

?
6

4-21-61

WATER WELL DRILLERS LOG

Date: April 21, 1961, Driller: C T Switzer Well Co. County Harrison
(Name)

(1) Owner of Land: <u>Horace Krohn</u> (Name)	Description & Color of Materials Sand, Clay, Red Clay, Shell, etc.	Thick- ness Feet	Depth Feet
<u>Tucker Road</u> (Address)	<u>Clay with sand streaks</u>	0	20
(2) Location: <u>1/4</u> , <u>1/4</u> , Sec. <u>1</u> T. <u>R.</u>	<u>Clay</u>	20	30
<u>1/4</u> miles <u>1/4</u> of <u>1</u> (distance) (direction) (Nearest Town)	<u>sand</u>	30	40
(3) Topography: <u>X</u> (Hilly) (Flat) (Level)	<u>Clay</u>	40	71
(4) Purpose of Well: <u>Domestic</u> (Domestic Irrigation Municipal, Industrial, Other)	<u>sand</u>	71	88
	<u>Clay</u>	88	108
	<u>sand</u>	108	125
	<u>Clay</u>	125	182
	<u>sand</u>	182	219
	<u>Clay</u>	219	258
	<u>sand</u>	258	283


Information upon completion of well:

- (1) Diameter 2" inches.
- (2) Total Depth 283 feet.
- (3) Water Level 28- feet below top of ground.
- (4) Cased to 283', Size 2"
- (5) Screen: Size 2", Length 10'
- (6) Were any formations sealed against pollution?
X yes, no.

If YES depth of formation _____

Why Health Dept Requirement

Drillers Remarks: _____

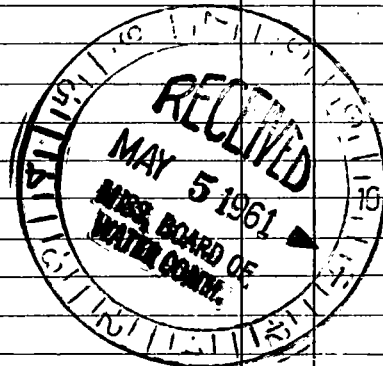

(Use Back Side)

Well No.

