

J 15
5-25-61

WATER WELL DRILLERS LOG

T 301
CODED

Date: 5-25, 1961, Driller: Jerry Bell County: Harrison
(Name)

(1) Owner of Land: Walter Parker
(Name)
RT 1 Pass Christian
(Address)

(2) Location: SW 1/4, NW 1/4, Sec 30 T7 R13
9 miles North of Pass C
(distance) (direction) (Nearest Town)

(3) Topography: (Hilly) (Flat) (Level)

(4) Purpose of Well: Home use
(Domestic Irrigation
Municipal, Industrial, Other)

| Description & Color of Materials Sand, Clay, Red Clay, Shell, etc. | Thick- ness Feet | Depth Feet |
|---|------------------------|---------------|
| <u>Red Clay + sand</u> | <u>20</u> | <u>20</u> |
| <u>40' white sand</u> | <u>40</u> | <u>60</u> |
| <u>Blue clay</u> | <u>40</u> | <u>100</u> |
| <u>Structure</u> | <u>17</u> | <u>17</u> |
| <u>Final Dgt</u> | | <u>117</u> |

CODED

Information upon completion of well:

(1) Diameter 2 1/4 inches.

(2) Total Depth 117 feet.

(3) Water Level 50 feet below top of ground.


(4) Cased to _____, Size _____

(5) Screen: Size 1/4, Length 10 ft

(6) Were any formations sealed against pollution?
_____ yes, _____ no.

If YES depth of formation _____
Why Back fill with sand

Drillers Remarks: _____

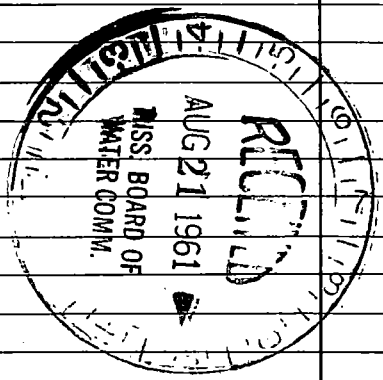

(Use Back Side)

Well No.

Handwritten text at the top of the page, including the name "Hanson" on the left and "11 2-52" on the right.

Red Glass roof 50
White roof 50
Regain Blue 80

RT1 Good Machine
Water Tanks
30 1 B
20 50
20 50
Water Tanks
20 50

Home use

5/11
117
20

1/11
10/1

Good fill with soap