

HAR.

MISSISSIPPI BOARD OF WATER COMMISSIONERS

J. 17

WATER WELL DRILLERS LOG

10-2-61

Date: 10-2, 1961, Driller: C. T. SWITZER WELL CO. County Harrison

(Name)

(1) Owner of Land: Robert L Fox (Name)

Tucker Road (Address)

(2) Location: 1/4, 1/4, Sec. T. R.

miles of (distance) (direction) (Nearest Town)

(3) Topography: X (Hilly) (Flat) (Level)

(4) Purpose of Well: Domestic (Domestic Irrigation Municipal, Industrial, Other)

Description & Color of Materials Sand, Clay, Red Clay, Shell, etc.	Thick- ness Feet	Depth Feet
clay	0	41
sand	41	53
clay	53	62
fine sand	62	92
clay	92	162
good sand	162	192
clay	192	227
good sand.	227	292


Information upon completion of well:

- (1) Diameter 2" inches.
- (2) Total Depth 292' feet.
- (3) Water Level 27' - feet below top of ground.
- (4) Cased to 292, Size 2"
- (5) Screen: Size 2", Length 10'
- (6) Were any formations sealed against pollution?  
X yes, no.

If YES depth of formation

Why Health Dept Requirement

Drillers Remarks:

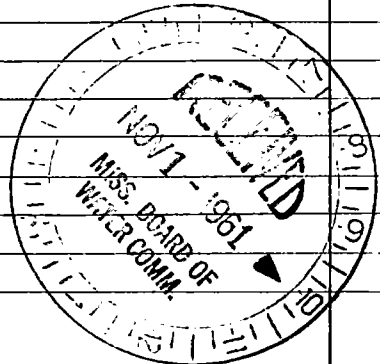

(Use Back Side)

Well No.

Handwritten notes at the top of the page, including a date and some illegible text.

Vertical handwritten notes on the left margin.

Vertical handwritten notes in the middle-left section.

Horizontal handwritten notes in the middle-right section.

Small handwritten note or signature in the middle.

Handwritten notes at the bottom of the page.