

HAR.

J 18

Q459813

WATER WELL DRILLERS LOG

CODED T-314

Date: 3-12-62 1962, Driller: Tony of Bell County Harrison

(1) Owner of Land: Neal P Jeffery (Name) New Orleans La. (Address)

(2) Location: SE 1/4, SE 1/4, Sec. 26 T.7 R.13, 9 miles North W, of Pass C (distance) (direction) (Nearest Town)

(3) Topography: X (Hilly) (Flat) (Level)

(4) Purpose of Well: Home (Domestic Irrigation Municipal, Industrial, Other)

Description & Color of Materials Sand, Clay, Red Clay, Shell, etc.	Thick- ness Feet	Depth Feet
Red Clay	15	15
Blue hard mud	45	60
Fine sand	20	80
Hard Blue mud	30	110
Strata for water	26	136

Total Depth 136

Information upon completion of well:

(1) Diameter 2' x 1/4" inches.

(2) Total Depth 136 feet.

(3) Water Level Small flow below top of ground.

(4) Cased to \_\_\_\_\_, Size \_\_\_\_\_

(5) Screen: Size 1/4, Length 10 ft.


(6) Were any formations sealed against pollution? Back fill with sand + mud yes, no.

If YES depth of formation \_\_\_\_\_

Why \_\_\_\_\_

Drillers Remarks: \_\_\_\_\_

CODED

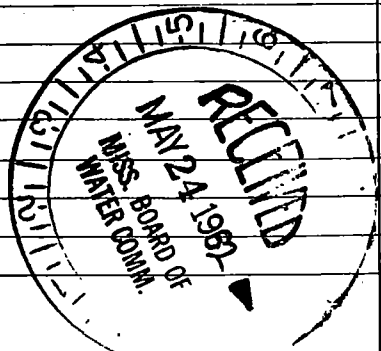

(Use Back Side)

Well No.

