

HAR. J 19

WATER WELL DRILLERS LOG

T 210
CODED

Date: 3/16, 1962, Driller: H. A. Ladner County Harrison
3-16-62 (Name)

(1) Owner of Land: Mrs. Ollie Herrin and Sam Bennett (Name)
Pineville, Miss. (Address)

(2) Location: 1/4, 1/4, Sec. 3 T. 25 N. R. 3 W. 1/2 miles north east of Pineville (distance) (direction) (Nearest Town)

(3) Topography: Level (Hilly) (Flat) (Level)

(4) Purpose of Well: Domestic (Domestic Irrigation) (Municipal, Industrial, Other)

Description & Color of Materials Sand, Clay, Red Clay, Shell, etc.	Thick- ness Feet	Depth Feet
Yellow Clay	20	
White, Red, and Gray Sand	180	
Blue clay	140	
Blue Sand	60	


Information upon completion of well:

- (1) Diameter 2 inches.
- (2) Total Depth 420 feet.
- (3) Water Level ~~420~~ 3 feet below top of ground.
- (4) Cased to 417, Size 2
- (5) Screen: Size 60, Length 15
- (6) Were any formations sealed against pollution?
 yes, no.

If YES depth of formation 200
Why Sand

Drillers Remarks:

CODED

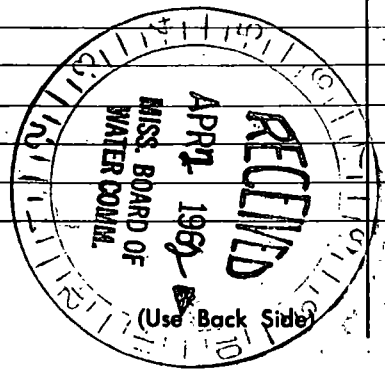

Well No.

1900

1900

