

HAR.

CODED

J 20

3-16-62

WATER WELL DRILLERS LOG

J-315

Date: 3-16, 1962, Driller: Sutton Well Works County Harrison

(Name)

(1) Owner of Land: <u>Eduw. Gregorich</u> (Name)	Description & Color of Materials Sand, Clay, Red Clay, Shell, etc.	Thick- ness Feet	Depth Feet
<u>De Lisle, Miss.</u> (Address)	<u>Clay</u>	<u>20</u>	<u>20</u>
(2) Location: <u>NE 1/4, SW 1/4, Sec. 34 T15R13W</u>	<u>Sand + gravel</u>	<u>100</u>	<u>120</u>
<u>3</u> miles <u>NW</u> , of <u>De Lisle</u> (distance) (direction) (Nearest Town)	<u>Clay</u>	<u>195</u>	<u>315</u>
(3) Topography: <u>hilly</u> (Hilly) (Flat) (Level)	<u>sand</u>	<u>20</u>	<u>335</u>
(4) Purpose of Well: <u>domestic</u> (Domestic Irrigation Municipal, Industrial, Other)			

CODED


Information upon completion of well:

- (1) Diameter 2 inches.
- (2) Total Depth 335 feet.
- (3) Water Level 35 feet below top of ground.
- (4) Cased to all, Size 2"
- (5) Screen: Size 2", Length 5'
- (6) Were any formations sealed against pollution?
no

If YES depth of formation _____

Why _____

Drillers Remarks: _____

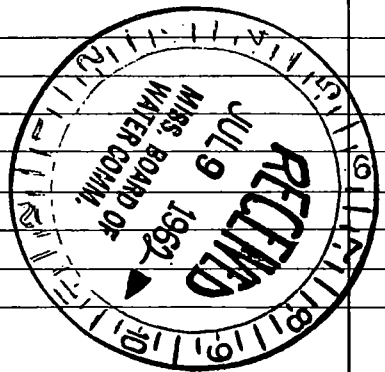

(Use Back Side)

Well No.

0100

Handwritten text at top left.

Handwritten text at top center.

Handwritten text at top right.

02 02
03 03
04 04
05 05

Handwritten notes in the middle left section.

Large handwritten section in the middle right, including a signature.

Handwritten text in the lower right quadrant.

Handwritten text at the bottom right.