

HARRISON

J 21

10-17-70

MISSISSIPPI BOARD OF WATER COMMISSIONERS  
416 North State Street  
Jackson, Mississippi 39201

**CODED**

WATER WELL DRILLERS LOG

10/17

19

20 *Fireville Well Co*

*Harrison*

date well completed

firm name

county well located

LANDOWNER: *Donita Sabra*

description of formations encountered

from to

*Rt 1 Box 149*

*top clay*

*0 10*

*Poss Christian Miss*  
(mailing address)

*red sand*

*10 16'*

WELL LOCATION:

sec. *18* T *7* R *13*  
*8 1/2* miles *SE* of *DeRidre*  
(distance) (direction) (nearest town)

*hard turbe pipe clay*

*16 155*

WELL PURPOSE: *home*  
(home, irrigation, municipal, industrial)

*hard sand & core*

*155 195*

WELL COMPLETION DATA:

- (1) diameter (inches) *2"*
- (2) total depth (feet) *175'*
- (3) static water level (feet) *18"* below top of ground.

- (4) casing *galv* *170*  
(material) (depth)

(size) If telescope see back.

- (5) screen *5* *170*  
(length) (depth to top)

*2"* *All SS.*  
(size) (material)

- (6) pump *1/2* *500 H*  
(HP) (yield gpm)

*Ebc 220*  
(type power)

- (7) electric log \_\_\_\_\_  
(yes or no)

(organization running log)

- (8) how well bottom plugged *Barb*  
*Went valve*

DRILLERS REMARKS:

**CODED**


*will read two more this week all for 1970*

MAR 3 - 1971

MISS. BD. OF WATER COMM.

If well telescopes please sketch and show depths.

GROUND LEVEL

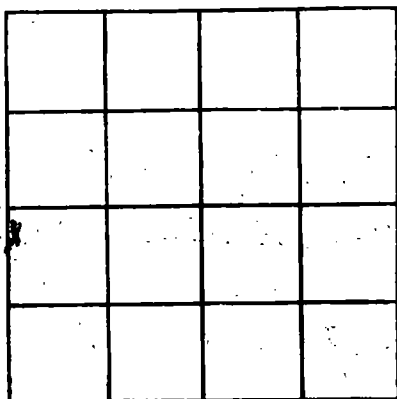

SECTION \_\_\_\_\_

Please indicate well location X.

ADDITIONAL INFORMATION

If more than one screen, show locations of each on sketch.