

J 22

5-5-62

WATER WELL DRILLERS LOG

T-313
CODED

Date: 5-5, 1962, Driller: J.B. County: Harrison

(Name)

(1) Owner of Land: Alphone Caroline
(Name)
PT 1 Bx 134 Cross Christian
(Address)

(2) Location: NE 1/4, NW 1/4, Sec 30 T7 R13
5 miles West, of Delisle
(distance) (direction) (Nearest Town)

(3) Topography: (Hilly) (Flat) (Level)

(4) Purpose of Well: Home
(Domestic Irrigation, Municipal, Industrial, Other)

Description & Color of Materials Sand, Clay, Red Clay, Shell, etc.	Thick- ness Feet	Depth Feet
<u>Red Clay</u>	<u>15</u>	<u>15</u>
<u>Blue Clay</u>	<u>30</u>	<u>45</u>
<u>Hard Blue Sand</u>	<u>60</u>	<u>105</u>
<u>Fine Blue Sand</u>	<u>15</u>	<u>120</u>
<u>Hard Blue mud</u>	<u>15</u>	<u>135</u>
<u>Strata</u>	<u>27</u>	<u>162</u>


CODED

Information upon completion of well:

- (1) Diameter: 2' 5 1/4 inches.
- (2) Total Depth: 162 feet.
- (3) Water Level: 20 feet below top of ground.
- (4) Cased to _____, Size _____.
- (5) Screen: Size 1 1/4", Length 10 ft.
- (6) Were any formations sealed against pollution?
_____ yes, _____ no.

Total Depth 162

If YES depth of formation _____
Why _____
Drillers Remarks: _____

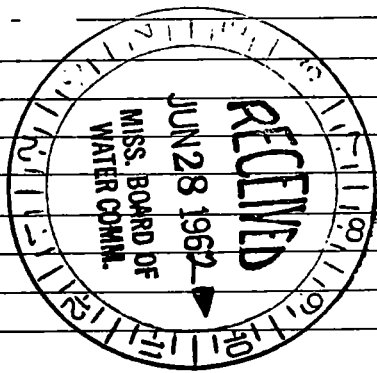

(Use Back Side)

Well No.

