

HAR.

J 23

6-15-62

WATER WELL DRILLERS LOG

J-312
CODED

Date: 6-15-62, 1962, Driller: J Beed County Jackson

(Name)

(1) Owner of Land: Ron Wattman
(Name)
RT 1 Pass Christian
(Address)

(2) Location: NE 1/4, SE 1/4, Sec 30 T7 R13
9 miles North of Pass Christian
(distance) (direction) (Nearest Town)

(3) Topography: (Hilly) (Flat) (Level)

(4) Purpose of Well:
(Domestic Irrigation
Municipal, Industrial, Other)

Description & Color of Materials Sand, Clay, Red Clay, Shell, etc.	Thick- ness Feet	Depth Feet
<u>lost mud & sand</u>	<u>65</u>	<u>65</u>
<u>Blue mud</u>	<u>40</u>	<u>105</u>
<u>Fine sand</u>	<u>10</u>	<u>115</u>
<u>Blue mud</u>	<u>30</u>	<u>145</u>
<u>fine sand</u>	<u>5</u>	<u>150</u>
<u>Dark Blue mud</u>	<u>89</u>	<u>239</u>
<u>stratta</u>	<u>35</u>	<u>274</u>

CODED

Information upon completion of well:

(1) Diameter 2" x 1/4" inches.

(2) Total Depth 274 feet.

(3) Water Level 25 ft feet below top of ground.


(4) Cased to _____, Size _____.

(5) Screen: Size 1/4", Length 10.

(6) Were any formations sealed against pollution?
_____ yes, _____ no.

If YES depth of formation _____
Why _____

Drillers Remarks: Back filled with sand

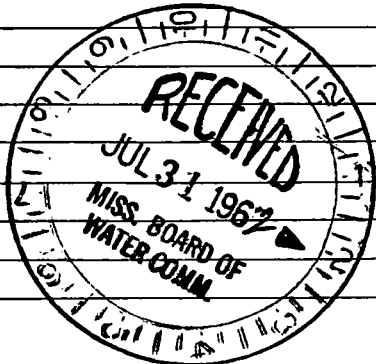

(Use Back Side)

Well No.

