

HAR.

MISSISSIPPI BOARD OF WATER COMMISSIONERS

J 26

7-30-62

WATER WELL DRILLERS

CODED

Date: 7-30, 1962, Driller: Sutter Well Works County Harrison
(Name)

(1) Owner of Land: Edison Martin
(Name)
Rt 1 Pass Christian
(Address)

(2) Location: SW 1/4, SW 1/4, Sec. 7 T28R13
7 miles NW of DeLisle
(distance) (direction) (Nearest Town)

(3) Topography: hilly
(Hilly) (Flat) (Level)

(4) Purpose of Well: domestic
(Domestic Irrigation
Municipal, Industrial, Other)

Description & Color of Materials Sand, Clay, Red Clay, Shell, etc.	Thick- ness Feet	Depth Feet
<u>Red Sand</u>	<u>30</u>	<u>30</u>
<u>Clay</u>	<u>105</u>	<u>135</u>
<u>Red</u>	<u>21</u>	<u>156</u>
<u>Clay - Sand streaks</u>	<u>204</u>	<u>360</u>
<u>Sand</u>	<u>35</u>	<u>395</u>

CODED

Information upon completion of well:

(1) Diameter 2 inches.

(2) Total Depth 395 feet.

(3) Water Level 10 feet below top of ground.

(4) Cased to all, Size 2"


(5) Screen: Size 2", Length 5'

(6) Were any formations sealed against pollution?
no

If YES depth of formation _____

Why _____

Drillers Remarks: _____

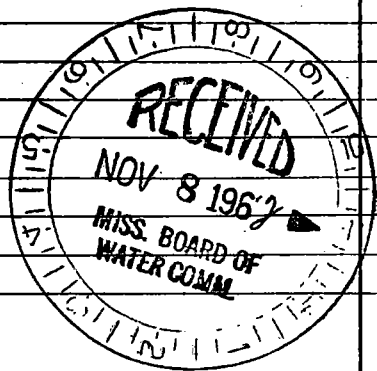

(Use Back Side)

Well No.

[The page contains extremely faint and illegible text, likely bleed-through from the reverse side of the document. The text is too light to transcribe accurately.]