

HAR.

MISSISSIPPI BOARD OF WATER COMMISSIONERS

J 27
8-14-62

WATER WELL DRILLERS CODED

Date: 8-14, 1962, Driller: J Reed County Harrison

(Name)

(1) Owner of Land: J. P. Moran
(Name)

Rt 1 Box 89 - F Pass Christian
(Address)

(2) Location: N 1/2 NE 1/4, NW 1/4, Sec. 18 T. 7 R. 13

10 miles East of Pass C
(distance) (direction) (Nearest Town)

(3) Topography: (Hilly) (Flat) (Level)

(4) Purpose of Well: Home
(Domestic Irrigation, Municipal, Industrial, Other)

Information upon completion of well:

(1) Diameter: 2" x 1 1/4" inches.

(2) Total Depth: 296 feet.

(3) Water Level: 18' feet below top of ground.

(4) Cased to _____, Size _____

(5) Screen: Size 1 1/4", Length 10 ft.

(6) Were any formations sealed against pollution?
_____ yes, _____ no.


If YES depth of formation _____

Why _____

Drillers Remarks: _____

Description & Color of Materials Sand, Clay, Red Clay, Shell, etc.	Thick- ness Feet	Depth Feet
White sand & mud	30	30
Blue mud	30	60
White sand	30	90
Hard Blue mud	190	260
water strata	36	296

CODED

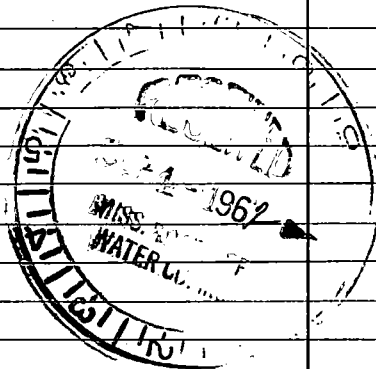

(Use Back Side)

Well No.

1954

1954

