

J29
9-7-62

WATER WELL DRILLERS LOG

CODED

Date: 9-7, 1962, Driller: J. Beal County: Warren
(Name)

(1) Owner of Land: Ed Sadner
(Name)
Rt 1 Pass Christian
(Address)
(2) Location: NW 1/4, SE 1/4, Sec 26 T.7R13
12 miles East of Pass C
(distance) (direction) (Nearest Town)
(3) Topography: X
(Hilly) (Flat) (Level)
(4) Purpose of Well: Home
(Domestic Irrigation, Municipal, Industrial, Other)


Description & Color of Materials Sand, Clay, Red Clay, Shell, etc.	Thick- ness Feet	Depth Feet
<u>Red clay</u>	<u>20</u>	<u>20</u>
<u>White sand</u>	<u>30</u>	<u>50</u>
<u>Blue mud part</u>	<u>13</u>	<u>63</u>
<u>White sand</u>	<u>42</u>	<u>105</u>
<u>Hard Blue sand</u>	<u>30</u>	<u>135</u>
<u>water strata</u>	<u>33</u>	<u>168</u>

CODED

Information upon completion of well:

(1) Diameter 2" x 1/4" inches.
(2) Total Depth 158 feet.
(3) Water Level 3 1/2 ft feet below top of ground.
(4) Cased to _____, Size _____
(5) Screen: Size 1/4", Length 10 ft
(6) Were any formations sealed against pollution?
_____ yes, _____ no.

If YES depth of formation _____
Why _____
Drillers Remarks: _____

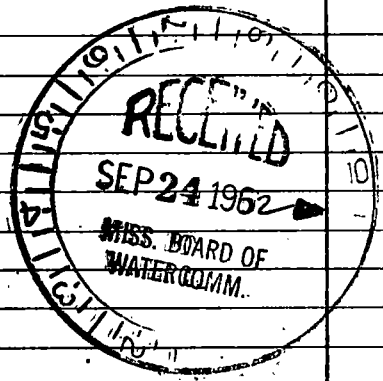

(Use Back Side)

Well No.

100

100