

HAR.

MISSISSIPPI BOARD OF WATER COMMISSIONERS


J35

2-1-63

WATER WELL DRILLERS LOG

Date: Feb 7, 1963, Driller: H. G. Ladner County Harrison
(Name)

	Description & Color of Materials Sand, Clay, Red Clay, Shell, etc.	Thick- ness Feet	Depth Feet
(1) Owner of Land: <u>Bill Bond</u> (Name) <u>Wolf River Road</u> (Address)	<u>white sand</u> <u>pink clay</u> <u>blue clay</u>	<u>15</u> <u>35</u> <u>118</u>	
(2) Location: <u>1/4</u> , <u>1/4</u> , Sec. <u>3</u> T7SR13W <u>7</u> miles <u>North</u> , of <u>Greenville</u> (distance) (direction) (Nearest Town)			
(3) Topography: <u>Flat</u> (Hilly) (Flat) (Level)			
(4) Purpose of Well: <u>Domestic</u> (Domestic Irrigation Municipal, Industrial, Other)			
Information upon completion of well:			
(1) Diameter <u>2</u> inches.			
(2) Total Depth <u>168</u> feet.			
(3) Water Level <u>25</u> feet below top of ground.			
(4) Cased to <u>160</u> , Size <u>2 inch</u>			
(5) Screen: Size <u>80</u> , Length <u>8 feet</u>			
(6) Were any formations sealed against pollution? <u>✓</u> yes, <u> </u> no.			
If YES depth of formation <u>35 feet</u>			
Why <u>sand</u>			
Drillers Remarks:			

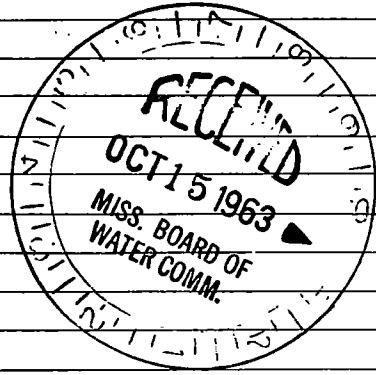

(Use Back Side)

Well No.

Handwritten text at the top of the page, possibly a title or header.

Handwritten text in the upper middle section, appearing to be a list or set of instructions.

Handwritten text below the upper middle section.

Handwritten text below the previous line.

Small handwritten text fragment.

Handwritten text at the bottom of the page.