

HAR.  
J37  
4-2-63

WATER WELL DRILLERS LOG

C. T. SWITZER WELL CO.

Date: 4-2, 1963, Driller: \_\_\_\_\_ County Hawaii

(Name)

(1) Owner of Land: \_\_\_\_\_

(Name)

Clyde Hampton

(Address)

(2) Location: \_\_\_\_\_ 1/4, \_\_\_\_\_ 1/4, Sec. \_\_\_\_\_ T. \_\_\_\_\_ R. \_\_\_\_\_

\_\_\_\_\_ miles \_\_\_\_\_ of \_\_\_\_\_  
(distance) (direction) (Nearest Town)

(3) Topography: \_\_\_\_\_

(Hilly) (Flat) (Level)

(4) Purpose of Well: Domestic

(Domestic Irrigation  
Municipal, Industrial, Other)

Description & Color of Materials Sand, Clay, Red Clay, Shell, etc.	Thick- ness Feet	Depth Feet
Clay	00	00
Sand, good	20	20
Clay	60	80
Sand	15	95
Sand, fair	50	145
Clay	10	155
Sand, fine	150	170
Clay	100	270
Sand, fair	230	260
Clay	260	330
Sand	337	300
Sand, fair	340	360
Sand, good	360	380

Information upon completion of well:

(1) Diameter 2" inches.

(2) Total Depth 380 feet.

(3) Water Level 21' feet below top of ground.

(4) Cased to 380', Size 2"

(5) Screen: Size 2", Length 10'


(6) Were any formations sealed against pollution?

yes, \_\_\_\_\_ no.

If YES depth of formation \_\_\_\_\_

Why Health Dept. requirement

Drillers Remarks: \_\_\_\_\_

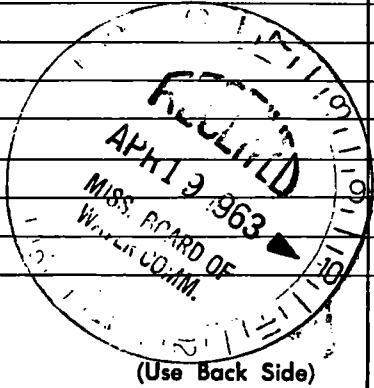

Well No.

