

HAR.

J38

4-24-63

WATER WELL DRILLERS LOG

CODED

Date: 4-24, 1963, Driller: Sutter Well Works County Harrison

(Name)

(1) Owner of Land: Irvin Dubisson

(Name)

Rt. 1 Pass Christian

(Address)

(2) Location: SW 1/4, SW 1/4, Sec. 23 T75R13W

3 miles N of Oshtemo

(distance)

(direction)

(Nearest Town)

(3) Topography: hilly

(Hilly)

(Flat)

(Level)

(4) Purpose of Well: domestic

(Domestic Irrigation
Municipal, Industrial, Other)

Description & Color of Materials
Sand, Clay, Red Clay, Shell, etc.

Thick-
ness
Feet

Depth
Feet

red clay - sand

60

60

clay

122

182

sand

38

220

CODED

Information upon completion of well:

(1) Diameter 2 inches.

(2) Total Depth 220 feet.

(3) Water Level 78 feet below top of ground.

(4) Cased to All, Size 2"

(5) Screen: Size 2", Length 5'


(6) Were any formations sealed against pollution?

yes, no.

If YES depth of formation

Why

Drillers Remarks:

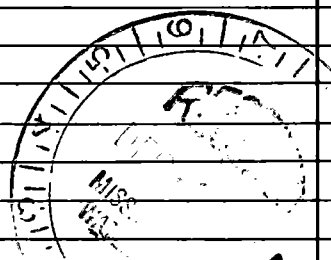

(Use Back Side)

Well No.

100

~~CONFIDENTIAL - SECURITY INFORMATION~~

CONFIDENTIAL - SECURITY INFORMATION

CONFIDENTIAL - SECURITY INFORMATION

