

HAR. MISSISSIPPI BOARD OF WATER COMMISSIONERS

J39  
4-24-63

WATER WELL DRILLERS LOG

**CODED**

Date: 4-24, 1963, Driller: Sutter Well Works County Harrison  
(Name)

(1) Owner of Land:	Description & Color of Materials Sand, Clay, Red Clay, Shell, etc.	Thick- ness Feet	Depth Feet
<u>Irvin Lubiusson</u> (Name) <u>Rt. 1 Pass Christian, Miss</u> (Address)	<u>Clay</u>	<u>23</u>	<u>23</u>
(2) Location: <u>NW 1/4, NE 1/4, Sec. 26 T25R13W</u>	<u>red sand</u>	<u>42</u>	<u>65</u>
<u>6</u> miles <u>N</u> of <u>DeLisle</u> (distance) (direction) (Nearest Town)	<u>Clay sand</u>	<u>125</u> <u>30</u>	<u>190</u> <u>220</u>
(3) Topography: <u>Hilly</u> (Hilly) (Flat) (Level)			
(4) Purpose of Well: <u>domestic</u> (Domestic Irrigation Municipal, Industrial, Other)			


Information upon completion of well:

- (1) Diameter 2 inches.
- (2) Total Depth 220 feet.
- (3) Water Level 82 feet below top of ground.
- (4) Cased to all, Size 2"
- (5) Screen: Size 2", Length 5'
- (6) Were any formations sealed against pollution?  
no

If YES depth of formation \_\_\_\_\_  
Why \_\_\_\_\_

Drillers Remarks: \_\_\_\_\_

**CODED**

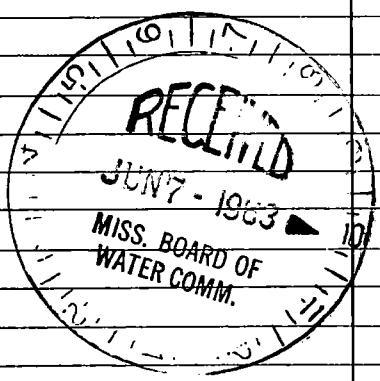

(Use Back Side)

Well No.

RECORDED

... ..

... ..

