

J 40  
4-24-63

WATER WELL DRILLERS LOG

**CODED**

Date: 4. 24, 1963, Driller: Sutter Well Works County Harrison

(Name)

(1) Owner of Land: Irvin Robinson  
(Name)  
Rt. 1 Pass Christian, Miss  
(Address)

Description & Color of Materials  
Sand, Clay, Red Clay, Shell, etc.

Thick-  
ness  
Feet

Depth  
Feet.

Clay

23

23

red sand

42

65

Clay

125

190

sand

30

220

(2) Location: NW 1/4, NE 1/4, Sec. 26 T 13 N, R 13 W

6 miles N of De Lisle  
(distance) (direction) (Nearest Town)

(3) Topography: hilly  
(Hilly) (Flat) (Level)

(4) Purpose of Well: domestic  
(Domestic Irrigation  
Municipal, Industrial, Other)

**CODED**


Information upon completion of well:

- (1) Diameter 2 inches.
- (2) Total Depth 220 feet.
- (3) Water Level 82 feet below top of ground.
- (4) Cased to all, Size 2"  
galv.
- (5) Screen: Size 2", Length 5'  
SS Johnson
- (6) Were any formations sealed against pollution?  
yes,  no.

f YES depth of formation \_\_\_\_\_

Why \_\_\_\_\_

Drillers Remarks: \_\_\_\_\_

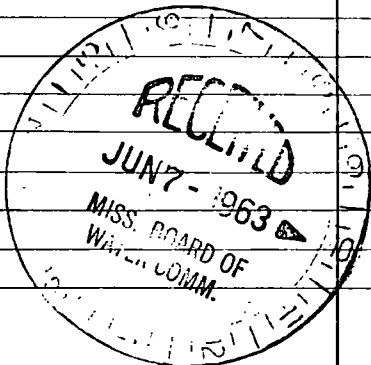

(Use Back Side)

Well No.

tain this copy for your office files.

