

J 41
6-4-63

WATER WELL DRILLERS LOG

7
CODED

Date: 6-4, 1963, Driller: J. Beard County Harrison
(Name)

(1) Owner of Land: Ulysses Garriga
(Name)
RT 1 Box Cass Christian
(Address)

(2) Location: 7E 1/4, 2W 1/4, Sec. 30, T. 7R13,
1.2 miles E, of Cass C
(distance) (direction) (Nearest Town)

(3) Topography: (Hilly) (Flat) (Level)

(4) Purpose of Well: Home
(Domestic Irrigation
Municipal, Industrial, Other)


Description & Color of Materials Sand, Clay, Red Clay, Shell, etc.	Thick- ness Feet	Depth Feet
<u>Red Clay</u>	<u>15</u>	<u>15</u>
<u>Red mud sand</u>	<u>40</u>	<u>55</u>
<u>Soft Blue mud</u>	<u>30</u>	<u>85</u>
<u>Hard Blue mud</u>	<u>71</u>	<u>156</u>
<u>Strata water</u>	<u>20</u>	<u>176</u>

Information upon completion of well:

- (1) Diameter 2" x 1/4 inches.
- (2) Total Depth 176 feet.
- (3) Water Level 30 feet below top of ground.
- (4) Cased to _____, Size _____.
- (5) Screen: Size 1/4, Length 10 ft.
- (6) Were any formations sealed against pollution?
_____ yes, _____ no.

If YES depth of formation _____
Why _____
Drillers Remarks: _____

CODED

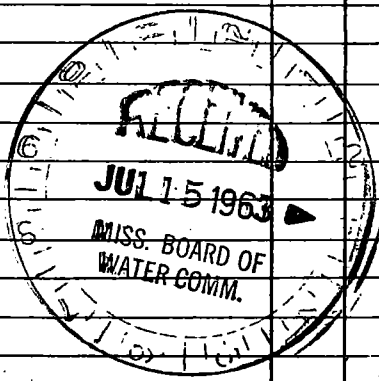

(Use Back Side)

Well No.

17300

