

J 42
6-8-63

WATER WELL DRILLERS LOG

CODED

Date: 6-8, 1963, Driller: J Reed County Harrison

(Name)

(1) Owner of Land: Merlin Labru
(Name)
Rt 1 Pass Christian
(Address)

(2) Location: SW 1/4, NW 1/4, Sec. 28 T7R13
12 miles N of Pass C
(distance) (direction) (Nearest Town)

(3) Topography: (Hilly) (Flat) (Level)

(4) Purpose of Well: Home
(Domestic Irrigation
Municipal, Industrial, Other)

Description & Color of Materials Sand, Clay, Red Clay, Shell, etc.	Thick- ness Feet	Depth Feet
<u>white soft mud</u>	<u>40</u>	<u>40</u>
<u>Blue mud</u>	<u>44</u>	<u>84</u>
<u>fine sand</u>	<u>21</u>	<u>105</u>
<u>Hard Blue mud</u>	<u>160</u>	<u>265</u>
<u>Water strata</u>	<u>40</u>	<u>305</u>

CODED


Information upon completion of well:

- (1) Diameter: 2" x 1/4" inches.
- (2) Total Depth 305 feet.
- (3) Water Level 45 feet below top of ground.
- (4) Cased to _____, Size _____
- (5) Screen: Size 1 1/4", Length 10 ft.
- (6) Were any formations sealed against pollution?
_____ yes, _____ no.

If YES depth of formation _____

Why _____

Drillers Remarks: _____

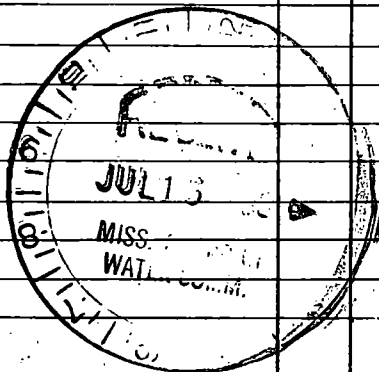

(Use Back Side)

Well No.

[The page contains extremely faint and illegible text, likely bleed-through from the reverse side of the paper. The text is arranged in several horizontal lines across the upper and middle portions of the page. A vertical line, possibly a page fold or a margin, is visible down the center. There are also some faint markings and symbols scattered throughout the page.]