

J 43

7-10-63

WATER WELL DRILLERS LOG

CODED

Date: July 10, 1963, Driller: L. Beek County: Harrison
 (Name)

(1) Owner of Land: Mrs E. Shayou
 (Name)
Pass Christian Rt 1
 (Address)

(2) Location: SW 1/4, SW 1/4, Sec. 3 T7 R13
6 miles N of Delisle
 (distance) (direction) (Nearest Town)

(3) Topography: (Hilly) (Flat) (Level)

(4) Purpose of Well: Home
 (Domestic Irrigation
 Municipal, Industrial, Other)

Description & Color of Materials Sand, Clay, Red Clay, Shell, etc.	Thick- ness Feet	Depth Feet
<u>Red mud + sand</u>	<u>105</u>	<u>105</u>
<u>Blue mud</u>	<u>125</u>	<u>230</u>
<u>Fine sand</u>	<u>15</u>	<u>245</u>
<u>Hard Blue mud</u>	<u>85</u>	<u>330</u>
<u>Fine sand</u>	<u>15</u>	<u>345</u>
<u>Hard Blue mud</u>	<u>30</u>	<u>375</u>
<u>Strata</u>	<u>30</u>	<u>410</u>

CODED

Information upon completion of well:

(1) Diameter: 2" x 1/4 inches.


(2) Total Depth: 410 feet.

(3) Water Level: 90' feet below top of ground.

(4) Cased to _____, Size _____

(5) Screen: Size 1 1/4, Length 20'

(6) Were any formations sealed against pollution?
 _____ yes, _____ no.

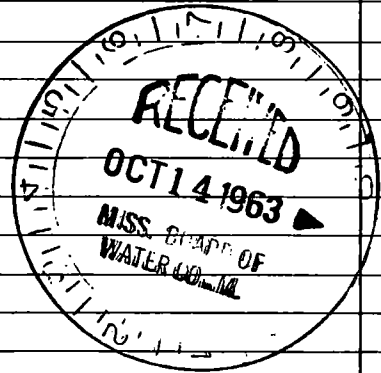

If YES depth of formation _____
 Why _____

Drillers Remarks:
Back filled with white sand

(Use Back Side)

Well No.

1900