

HAR.

J 44 WATER WELL DRILLERS LOG

8-13-63

Date: Aug. 13, 1963, Driller: A. A. Ladner County Harrison

(Name)

(1) Owner of Land: <u>Holland Ladner</u> (Name)	Description & Color of Materials Sand, Clay, Red Clay, Shell, etc.	Thick- ness Feet	Depth Feet
<u>Rocky Hill</u> (Address)	<u>Yellow clay</u>	<u>20</u>	
(2) Location: <u>1/4</u> , <u>1/4</u> , Sec. <u>3 T2S R13W</u>	<u>Red sand</u>	<u>20</u>	
<u>4</u> miles <u>North</u> of <u>Kilm</u> (distance) (direction) (Nearest Town)	<u>Blue clay</u>	<u>142</u>	
(3) Topography: <u>Hilly</u> (Hilly) (Flat) (Level)			
(4) Purpose of Well: <u>Domestic</u> (Domestic Irrigation Municipal, Industrial, Other)			


Information upon completion of well:

- (1) Diameter 2 inches.
- (2) Total Depth 190 feet.
- (3) Water level 35 feet below top of ground.
- (4) Cased to 182, Size 2 inch
- (5) Screen: Size 2 inch Length 8
- (6) Were any formations sealed against pollution?
 yes, no.

If YES depth of formation 20

Why sand

Drillers Remarks:

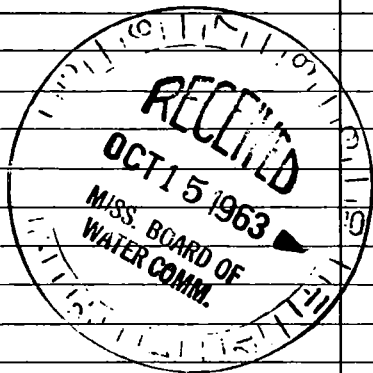

(Use Back Side)

Well No.

