

HARRISON
J45

WATER WELL DRILLERS LOG

9-9-63

Date Sept 9, 1963, Driller: L Reed County _____
(Name)


(1) Owner of Land: L Hudson
(Name)
RT 1 Cars Christian
(Address)

(2) Location: _____ 1/4, _____ 1/4, Sec. _____ T. R. _____
4 miles N of Delisle
(distance) (direction) (Nearest Town)

(3) Topography: (Hilly) (Flat) (Level)

(4) Purpose of Well: Home & Farm
(Domestic Irrigation
Municipal, Industrial, Other)

Description & Color of Materials Sand, Clay, Red Clay, Shell, etc.	Thick- ness Feet	Depth Feet
<u>Red mud + clay</u>	<u>125</u>	<u>125</u>
<u>Hard Blue mud</u>	<u>90</u>	<u>215</u>
<u>Fine sand</u>	<u>30</u>	<u>245</u>
<u>Coarse white sand</u>	<u>50</u>	<u>295</u>
<u>Hard Blue mud</u>	<u>161</u>	<u>456</u>
<u>Shatter</u>	<u>25</u>	<u>481</u>

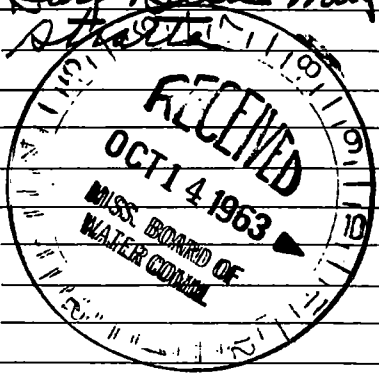

Information upon completion of well:

(1) Diameter 2 1/2 inches.

(2) Total Depth 481 feet.

(3) Water Level 70 feet below top of ground.

(4) Cased to _____, Size _____.

(5) Screen: Size 2', Length 15'.

(6) Were any formations sealed against pollution?
_____ yes, _____ no.

If YES depth of formation _____

Why _____

Drillers Remarks: _____

Well No.

(Use Back Side)

