

J 46  
9-18-63

WATER WELL DRILLERS LOG

**CODED**

Date: 9-18, 1963, Driller: Jutter Well Works County Harrison  
(Name)

(1) Owner of Land: Ursand Ladner  
(Name)  
Rt 1 Pass Christian  
(Address)  
(2) Location: NE 1/4, NW 1/4, Sec. 9 T5R12W  
5 miles N of Delisle  
(distance) (direction) (Nearest Town)  
(3) Topography: Hilly  
(Hilly) (Flat) (Level)  
(4) Purpose of Well: domestic  
(Domestic Irrigation  
Municipal, Industrial, Other)

Description & Color of Materials Sand, Clay, Red Clay, Shell, etc.	Thick- ness Feet	Depth Feet
Clay	10	10
sand	53	63
Clay/gravel	38	101
Clay	36	147
sand	31	178
Clay	14	192
sand	33	225
Clay	17	242
sand	13	255
Clay	102	357
sand	17	374
Clay	53	427
sand	42	469


Information upon completion of well:

(1) Diameter 2 inches.  
(2) Total Depth 469 feet.  
(3) Water Level 50 feet below top of ground.  
(4) Cased to all, Size 2"  
(5) Screen: Size 2", Length 10'  
(6) Were any formations sealed against pollution?  
yes, ✓ no.

If YES depth of formation \_\_\_\_\_  
Why \_\_\_\_\_

Drillers Remarks: \_\_\_\_\_  
\_\_\_\_\_  
\_\_\_\_\_

**CODED**

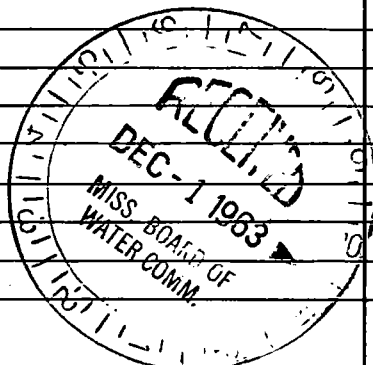

(Use Back Side)

Well No.



Faint header text or date at the top of the page.

Vertical list of text on the left side of the page.

Vertical list of text in the middle-left section of the page.

Large block of text or notes on the right side of the page.

Vertical list of text on the right side of the page, lower down.