

HAR.

J 47
11-28-63

WATER WELL DRILLERS LOG **CODED**

Date: 11-28, 1963, Driller: J Beach County Harrison
(Name)

(1) Owner of Land: Christine Lizona
(Name)
RT 1 Pass Christian
(Address)

(2) Location: NW 1/4, SW 1/4, Sec. 20 T7 R13
5 miles North of Delisle
(distance) (direction) (Nearest Town)

(3) Topography: (Hilly) (Flat) (Level)

(4) Purpose of Well: Home
(Domestic Irrigation
Municipal, Industrial, Other)

Description & Color of Materials Sand, Clay, Red Clay, Shell, etc.	Thick- ness Feet	Depth Feet
<u>Red clay</u>	<u>15</u>	<u>15</u>
<u>" sand + white</u>	<u>20</u>	<u>35</u>
<u>White soft mud</u>	<u>25</u>	<u>60</u>
<u>white sand</u>	<u>10</u>	<u>70</u>
<u>Hard Blue mud</u>	<u>174</u>	<u>244</u>
<u>water strata</u>	<u>20</u>	<u>264</u>

CODED

Information upon completion of well:

(1) Diameter 2" x 1 1/4" inches.

(2) Total Depth 264 feet.

(3) Water Level 55 ft feet below top of ground.

(4) Cased to _____, Size _____


(5) Screen: Size 1/4", Length 15 ft

(6) Were any formations sealed against pollution?
_____ yes, _____ no.

If YES depth of formation _____

Why _____

Drillers Remarks: _____

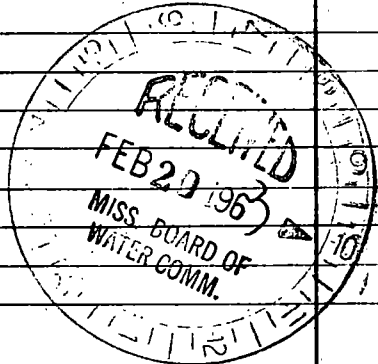

(Use Back Side)

Well No.

