

HAR,  
J 48  
12-9-63

WATER WELL DRILLERS LOG

**CODED**

Date: 12-9, 1963, Driller: J Beard County Harrison

(Name)

(1) Owner of Land: Louis Ledno  
(Name)  
RT 1 Box 128-13 Pan Christ  
(Address)

Description & Color of Materials Sand, Clay, Red Clay, Shell, etc.	Thick- ness Feet	Depth Feet
<u>Red Sand &amp; Mud</u>	<u>126</u>	<u>126</u>
<u>Hard Blue Mud</u>	<u>154</u>	<u>280</u>
<u>Water Strata</u>	<u>30</u>	<u>310</u>

(2) Location: NW 1/4, NW 1/4, Sec. 30 T7 R12  
8 miles West of Pan Christ  
(distance) (direction) (Nearest Town)

(3) Topography: V  
(Hilly) (Flat) (Level)

(4) Purpose of Well: Home  
(Domestic Irrigation  
Municipal, Industrial, Other)

Information upon completion of well:


- (1) Diameter 2" x 1/4" inches.
- (2) Total Depth 310 feet.
- (3) Water Level 22 feet below top of ground.
- (4) Cased to \_\_\_\_\_, Size \_\_\_\_\_.
- (5) Screen: Size 1/4", Length 10'.
- (6) Were any formations sealed against pollution?  
\_\_\_\_\_ yes, \_\_\_\_\_ no.

If YES depth of formation \_\_\_\_\_

Why \_\_\_\_\_

Drillers Remarks: \_\_\_\_\_

**CODED**

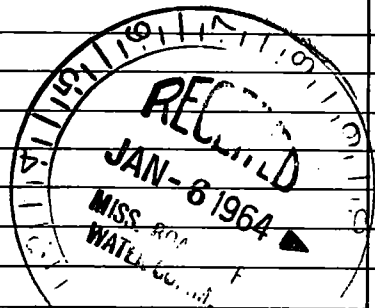

Well No.

(Use Back Side)

1000