

HAR.

J 49
12-19-63

WATER WELL DRILLERS LOG

CODED

Date: 12-19, 1963, Driller: Sutton Well Works Harrison County

(Name)

(1) Owner of Land: W.P. Bowers

(Name)

Bay St. Louis, Miss.

(Address)

(2) Location: SW 1/4, SW 1/4, Sec. 23 T 76 R 13, W

5 miles N, of Osborne

(distance)

(direction)

(Nearest Town)

(3) Topography: hilly

(Hilly)

(Flat)

(Level)

(4) Purpose of Well: domestic

(Domestic Irrigation
Municipal, Industrial, Other)

Description & Color of Materials
Sand, Clay, Red Clay, Shell, etc.

Thick-
ness
Feet

Depth
Feet

Clay - sand

25

25

red sand

58

83

Clay

46

129

sand

22

151

Clay

81

232

sand

18

250

Clay

77

327

sand

31

358

Clay

20

378

sand

17

395

Information upon completion of well:

(1) Diameter 2 inches.

(2) Total Depth 395 feet.

(3) Water Level 54 feet below top of ground.

(4) Cased to all, Size 2"

(5) Screen: Size 2", Length 10'

(6) Were any formations sealed against pollution?


no yes, no.

If YES depth of formation _____

Why _____

Drillers Remarks: _____

CODED

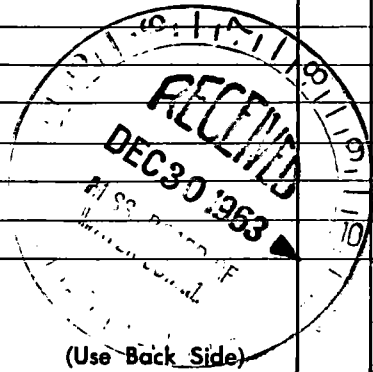

(Use Back Side)

Well No.

01000

...

... ..

... ..

... ..